


T.4S.R.2W.W.M.

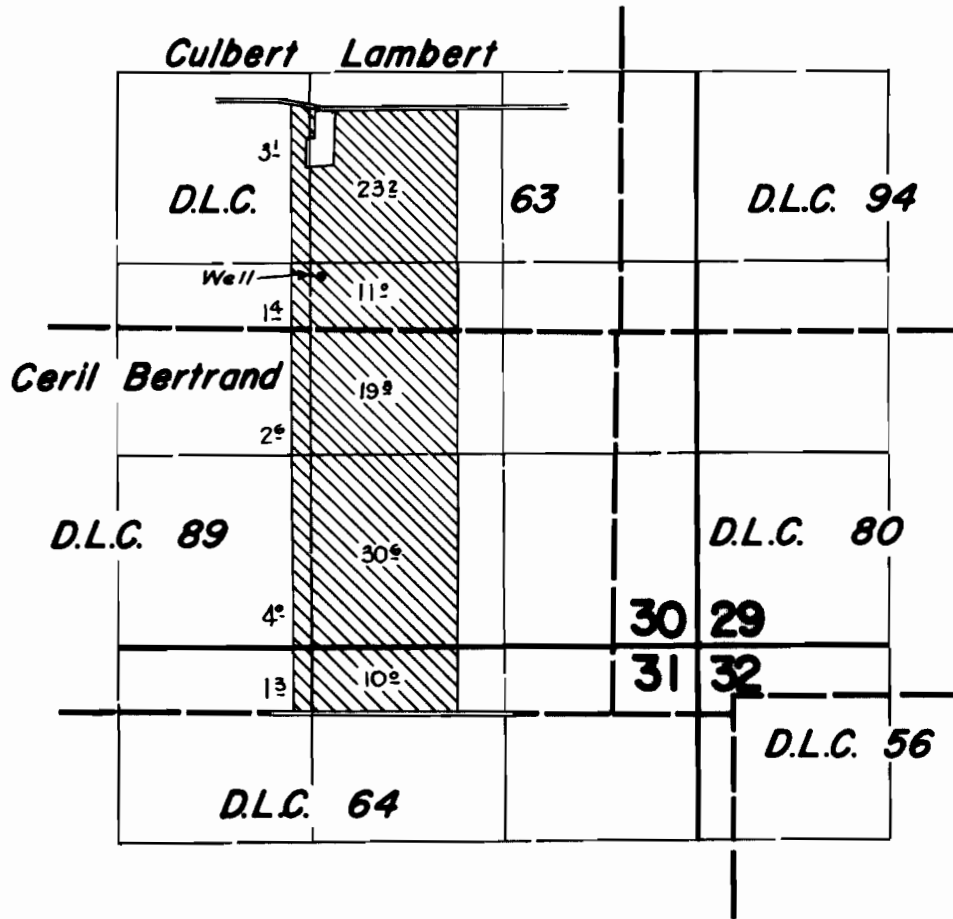

FINAL PROOF SURVEY UNDER

Application No. G:491..... Permit No. G:355.....
IN NAME OF

EDWARD F. DAVIDSON

Surveyed March 23 1962, by R. Jackson