


T.5S. R.1W.W.M,

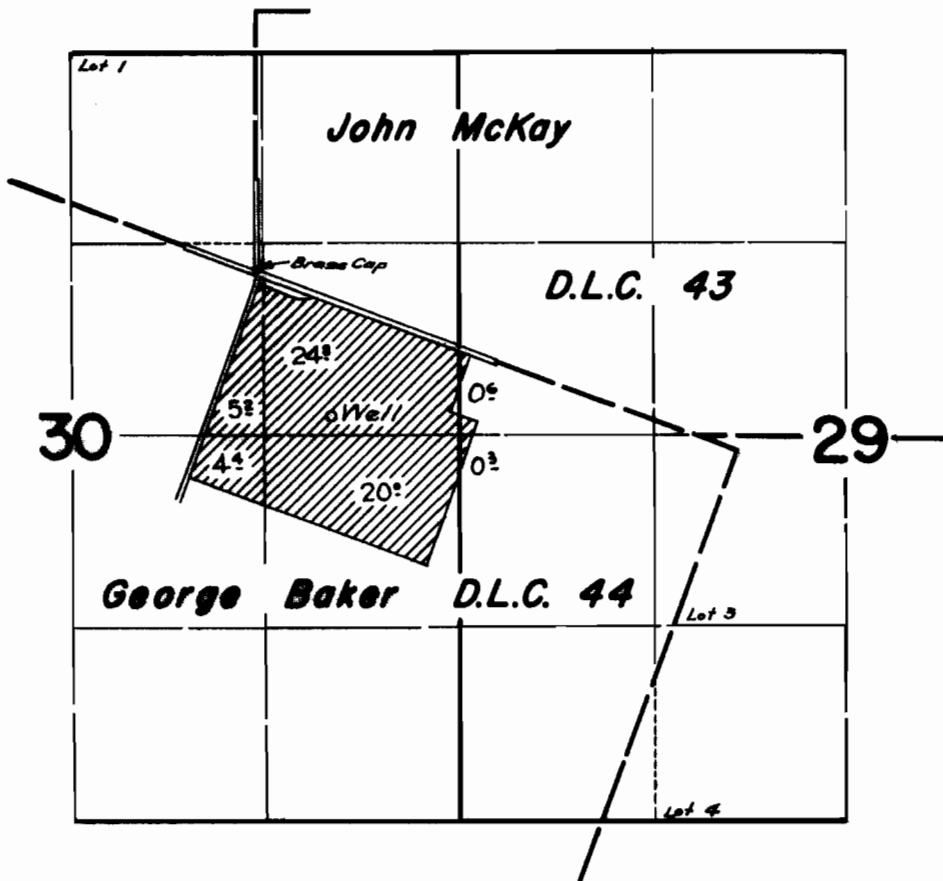

FINAL PROOF SURVEY UNDER

Application No. G-923... Permit No. G-785...
IN NAME OF

THE ESTATE OF BERNARD N. MILLER

Surveyed March 22 1962, by *A. H. Johnson*