


T.4S.R.2W.W.M.

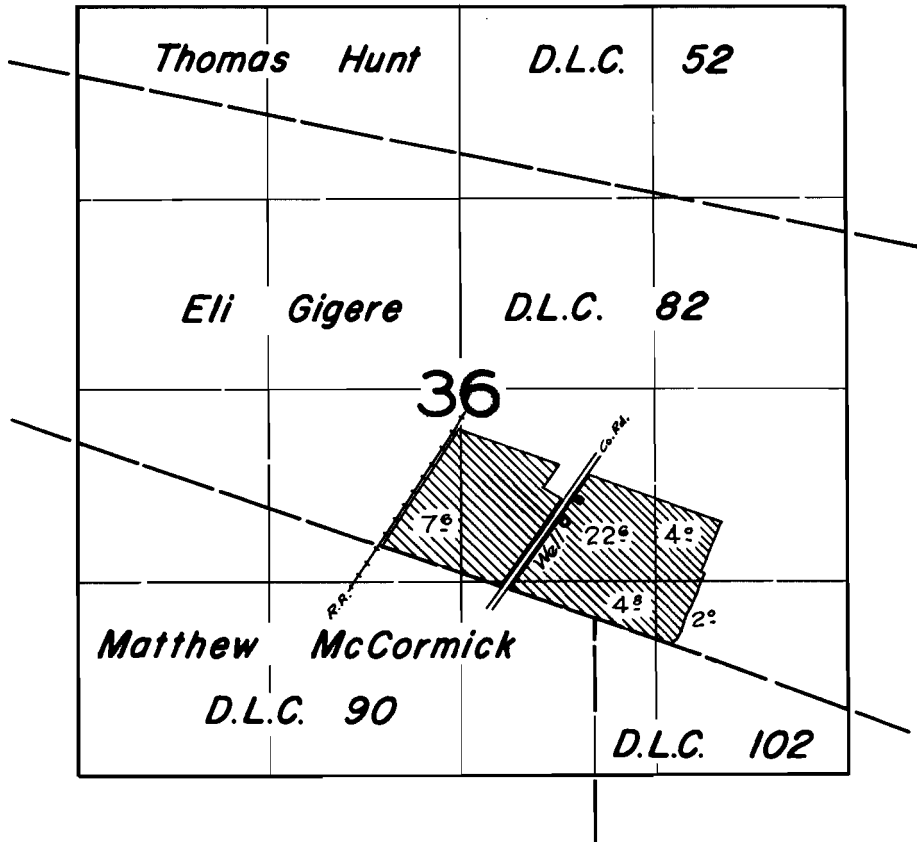

FINAL PROOF SURVEY UNDER

Application No. G-1362... Permit No. G-1238...
IN NAME OF

ESTATE OF ELGIN LUCAS

Surveyed June 20 1962, by

A. Jackson