


T.6S.R.3W.W.M.

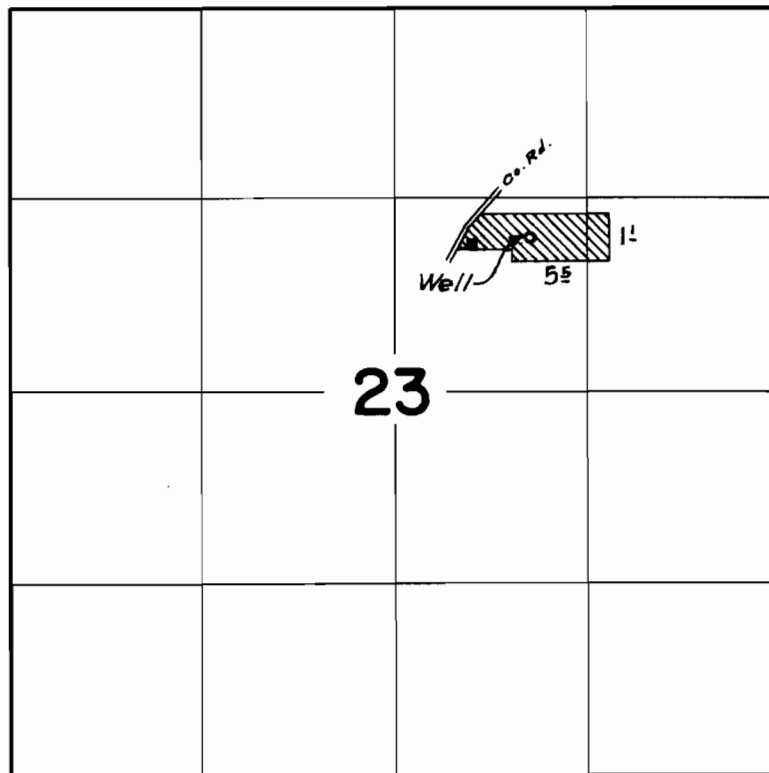

FINAL PROOF SURVEY UNDER

Application No. G-1365 Permit No. G-1240
IN NAME OF

JAMES P. MINOT

Surveyed March 27 1902, by

Refelson