


T.8S.R.2W.W.M.

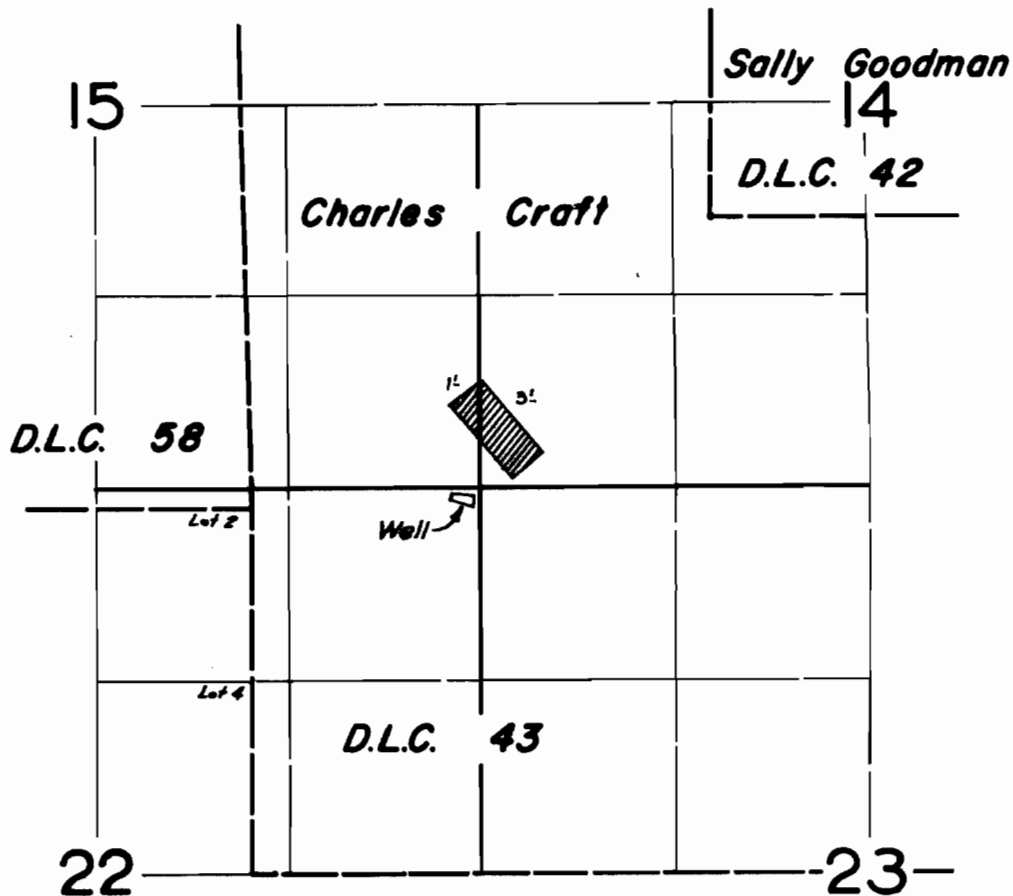

FINAL PROOF SURVEY

UNDER

Application No. 9-1418... Permit No. 9-1288...
IN NAME OF

W. J. LULAY

Surveyed May 31, 1962, by

1962-K