


T. 6 S., R. 3 W., 11 M.  
 Section 24  
 Scale 1"=400'

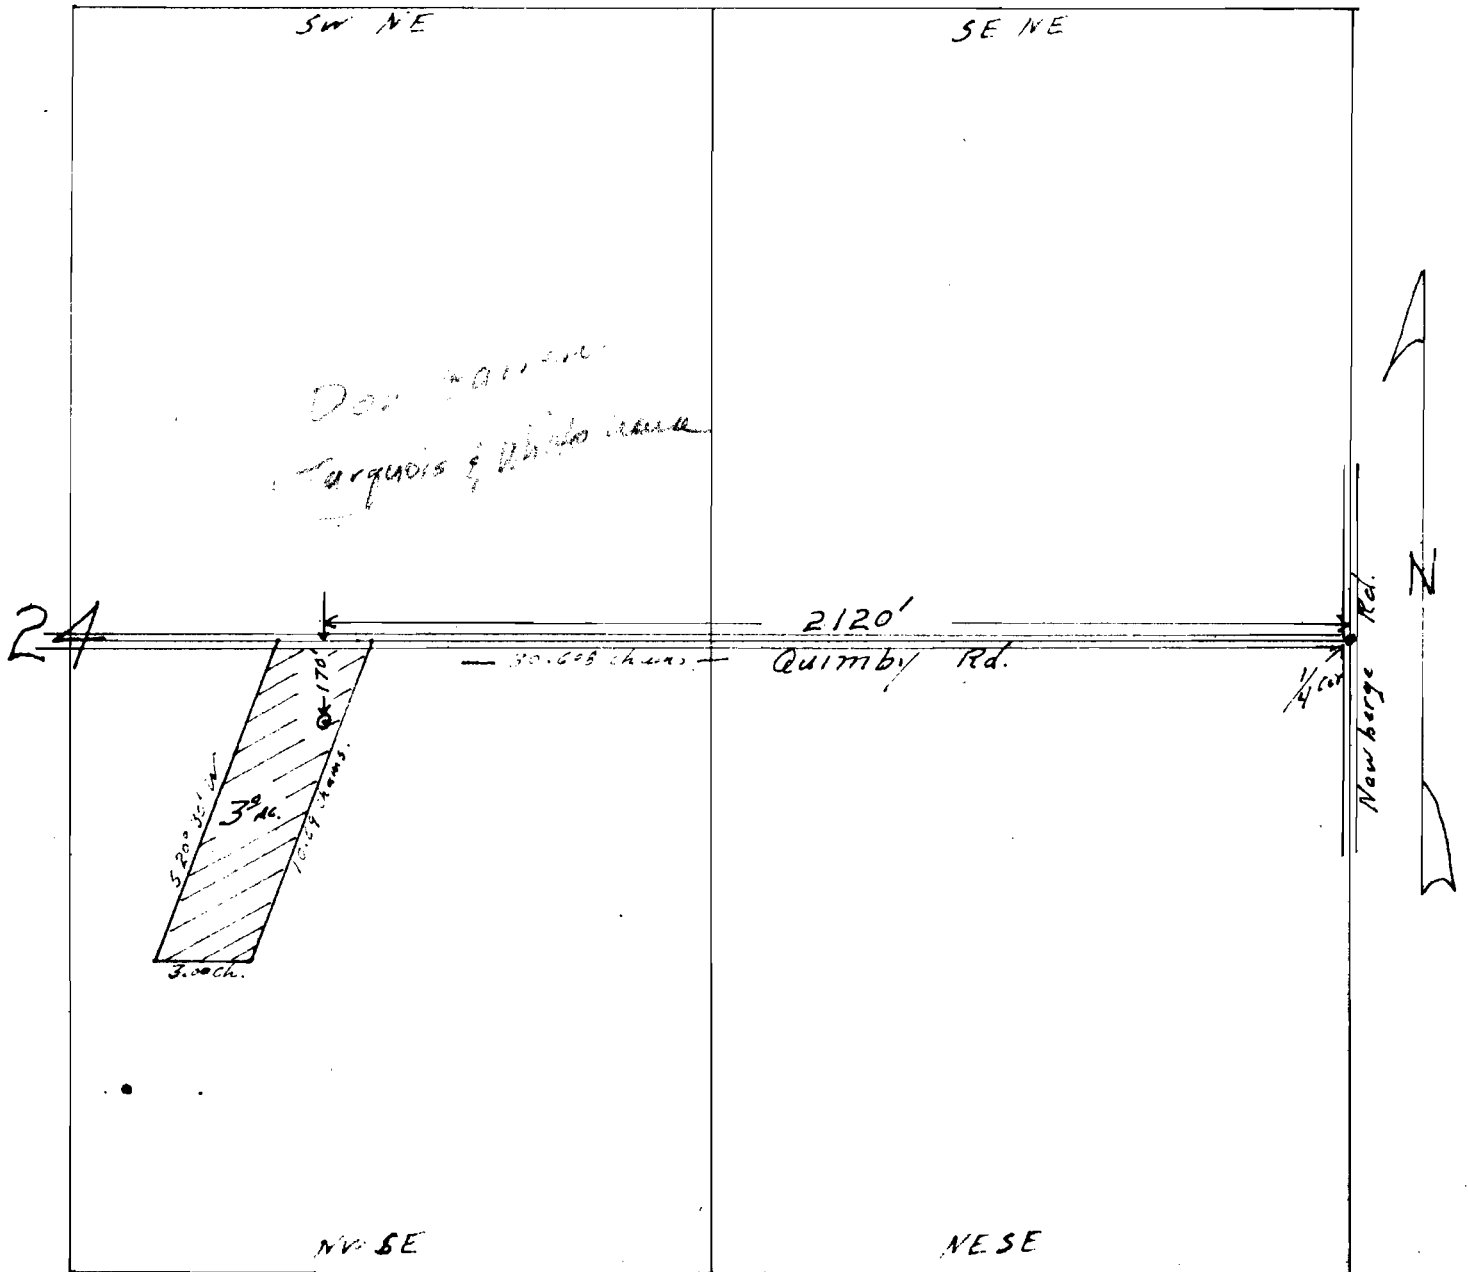

Application No. G-1515  
 Permit No. G-1383