


T. 8 S. R. 1 W. W. M.

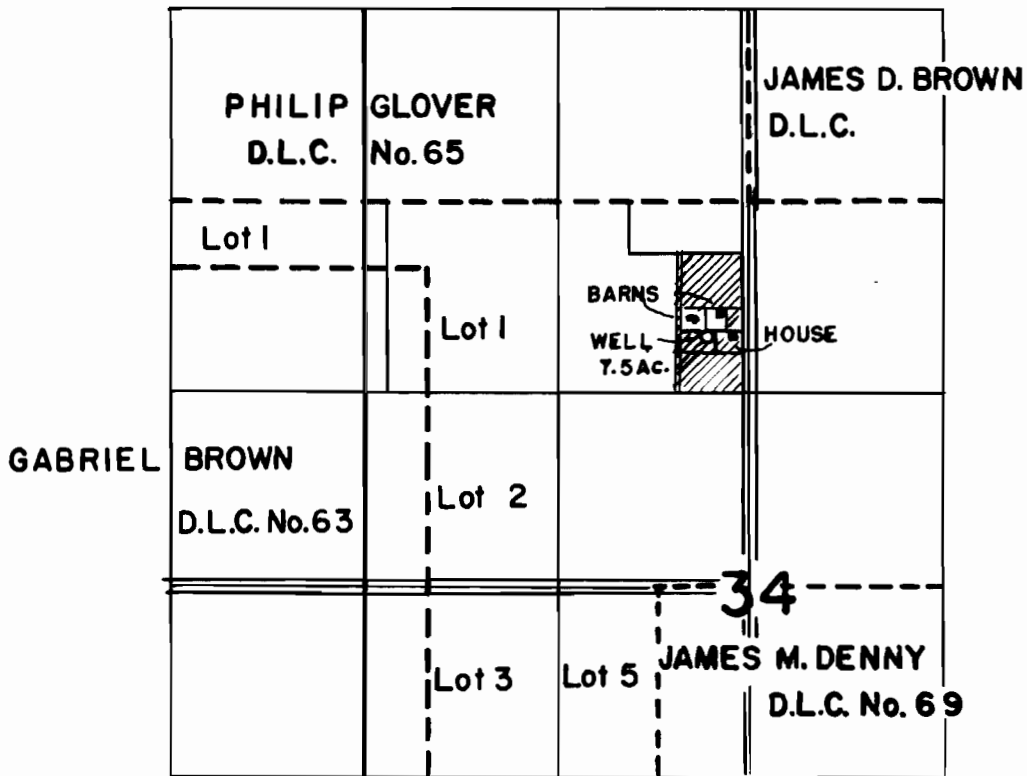

FINAL PROOF SURVEY
UNDER

Application No. G 1544 Permit No. G-1413
IN NAME OF

ROBERT M. STUCKART

Surveyed October 17 1962, by *Floyd L. Sigmond*