


T.6S.R.2W.W.M.

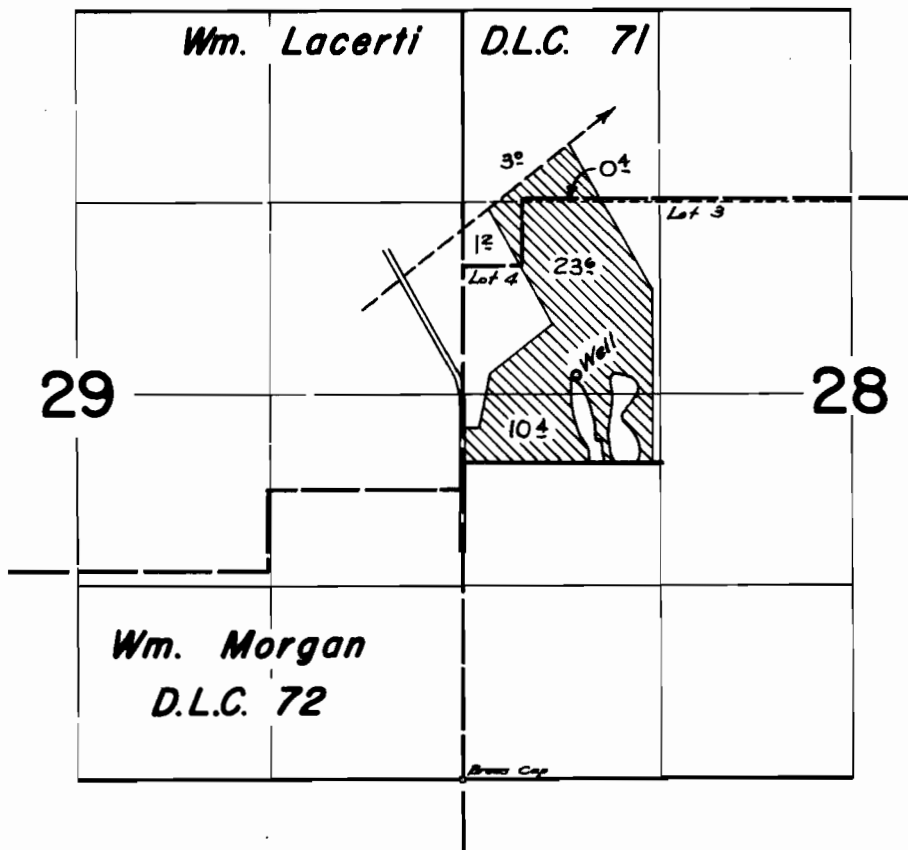

FINAL PROOF SURVEY UNDER

Application No. G-1786... Permit No. G-1637.
IN NAME OF

MRS. A. GARBARINO

Surveyed March 30 1962, by