


T.9 S.R.1 W. W.M.

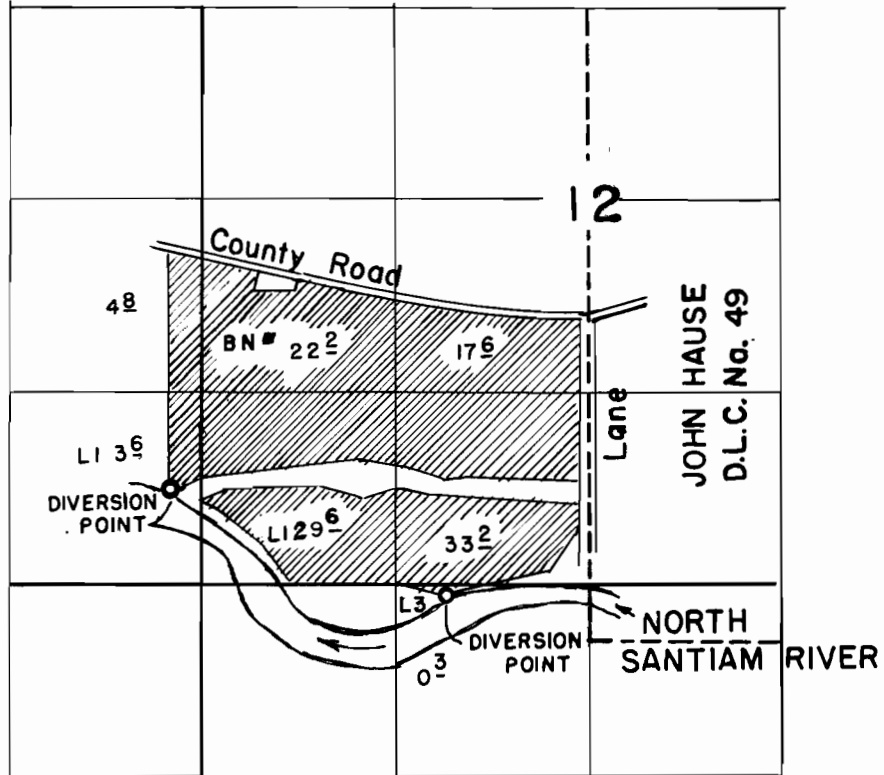

**FINAL PROOF SURVEY**  
UNDER

30930                      24342  
Application No. 30631    Permit No. 24132  
IN NAME OF

**Zimmerman Brothers**

Surveyed Oct. 26 1962, by *Floyd L. Sigmond*