


T.8S.R.2W.W.M.

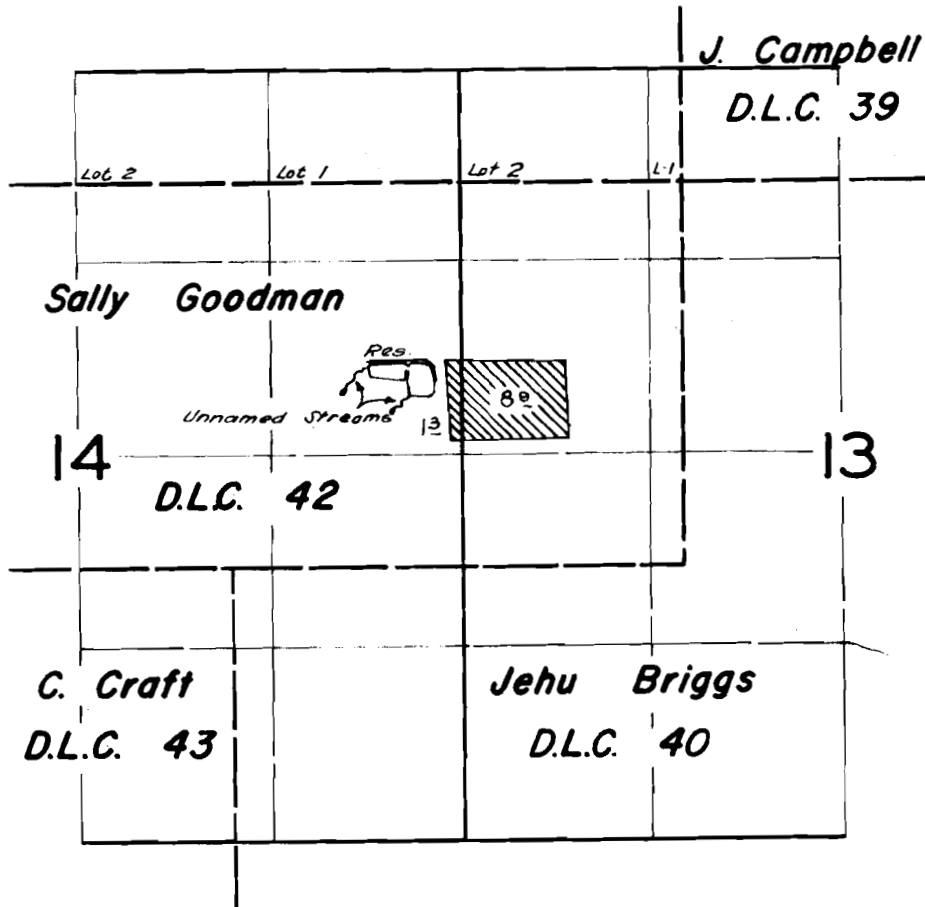

FINAL PROOF SURVEY
UNDER

Application No. **R-32553** Permit No. **R-2171**
32554 **25705**
IN NAME OF

FRED & MARY GILBERT

Surveyed May 31, 1962, by *L. Jackson*