


T.8S.R.2W.W.M.

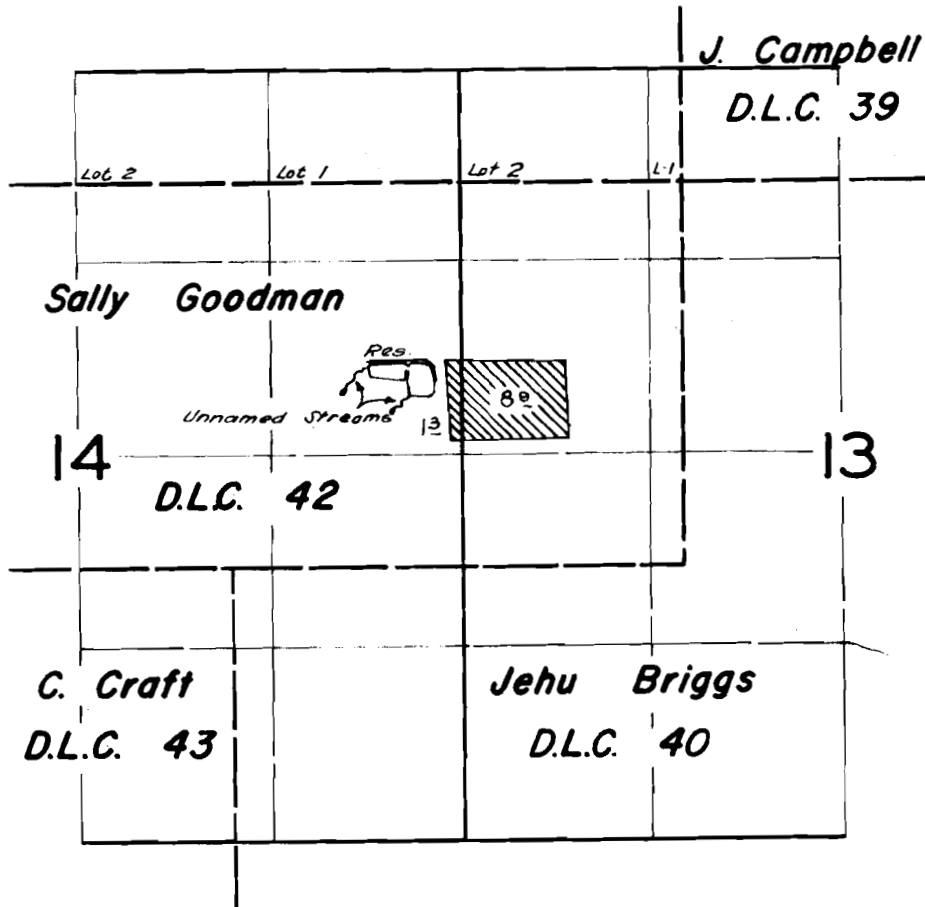

FINAL PROOF SURVEY  
UNDER

Application No. **R-32553**  
**32554** Permit No. **R-2171**  
**25705**  
IN NAME OF

FRED & MARY GILBERT

Surveyed May 31, 1962, by *L. Jackson*