


T. 6 S. R. 1 E. W. M.

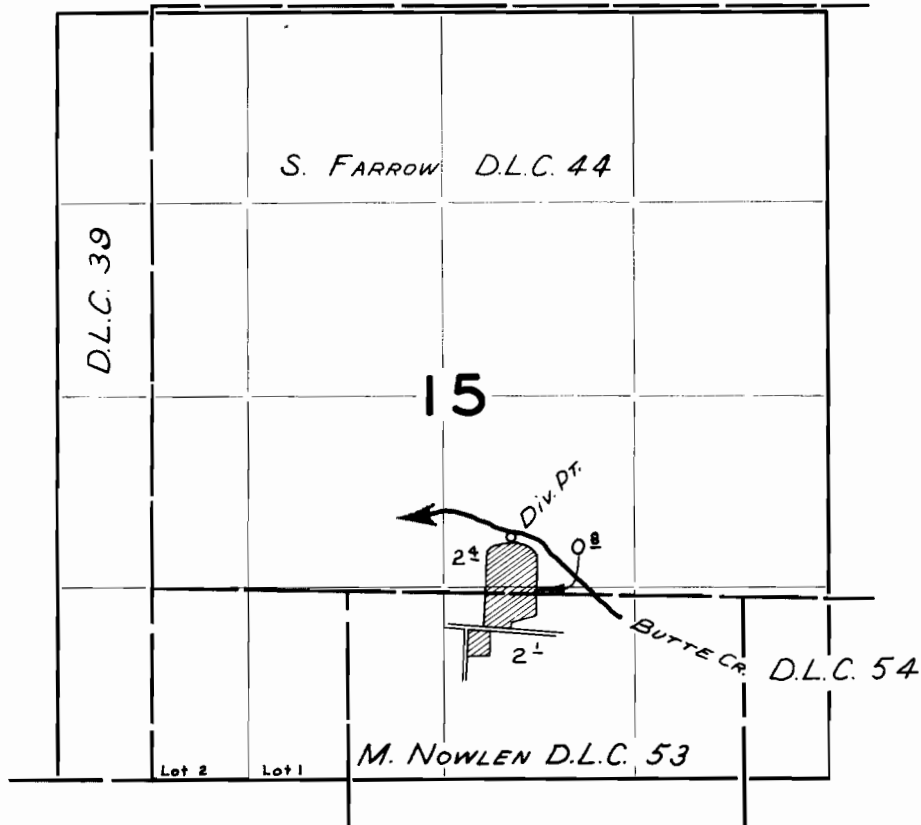

**FINAL PROOF SURVEY**  
UNDER

Application No. 32569 Permit No. 25711  
IN NAME OF

**CLAUDE & LUCILLE M. NORTON**

Surveyed APR. 19 1962, by R. JACKSON