


T.6S.R.1W.W.M.

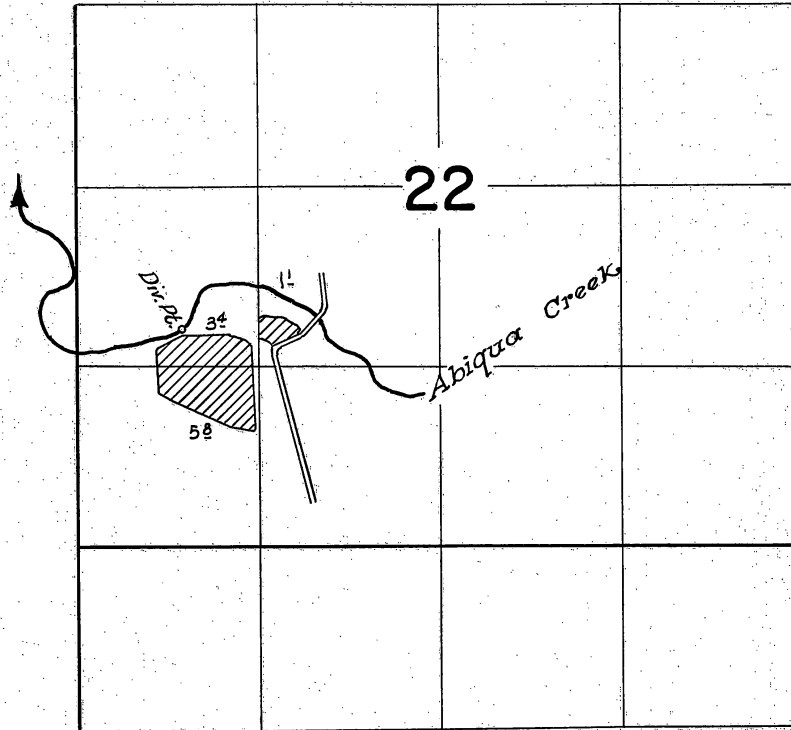

FINAL PROOF SURVEY
UNDER

Application No. 33615... Permit No. 26580...
IN NAME OF

ESTATE OF BONNIE H. BEHREND

Surveyed April 20 1962, by