


T.6S.R.2W.W.M.

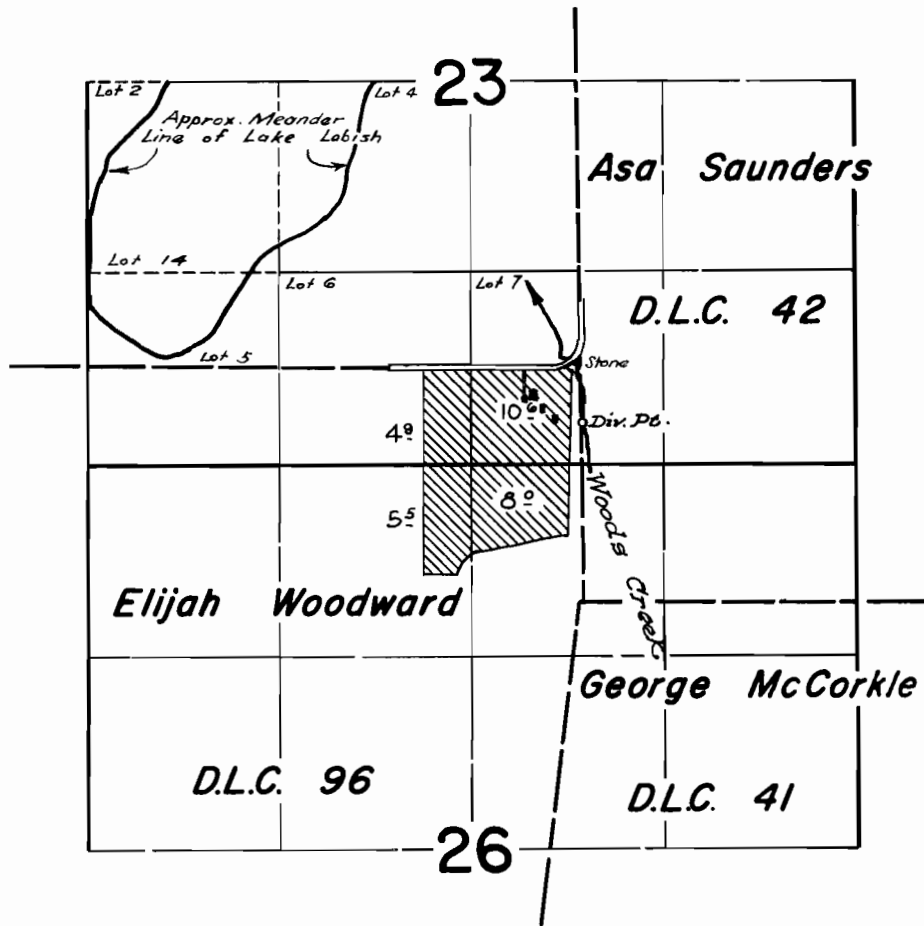

FINAL PROOF SURVEY
UNDER

Application No. 34463. Permit No. 27069.
IN NAME OF

LEWIS R. SAWYER

Surveyed March 29 1962, by *[Signature]*