


T.6N.R.34E.W.M.

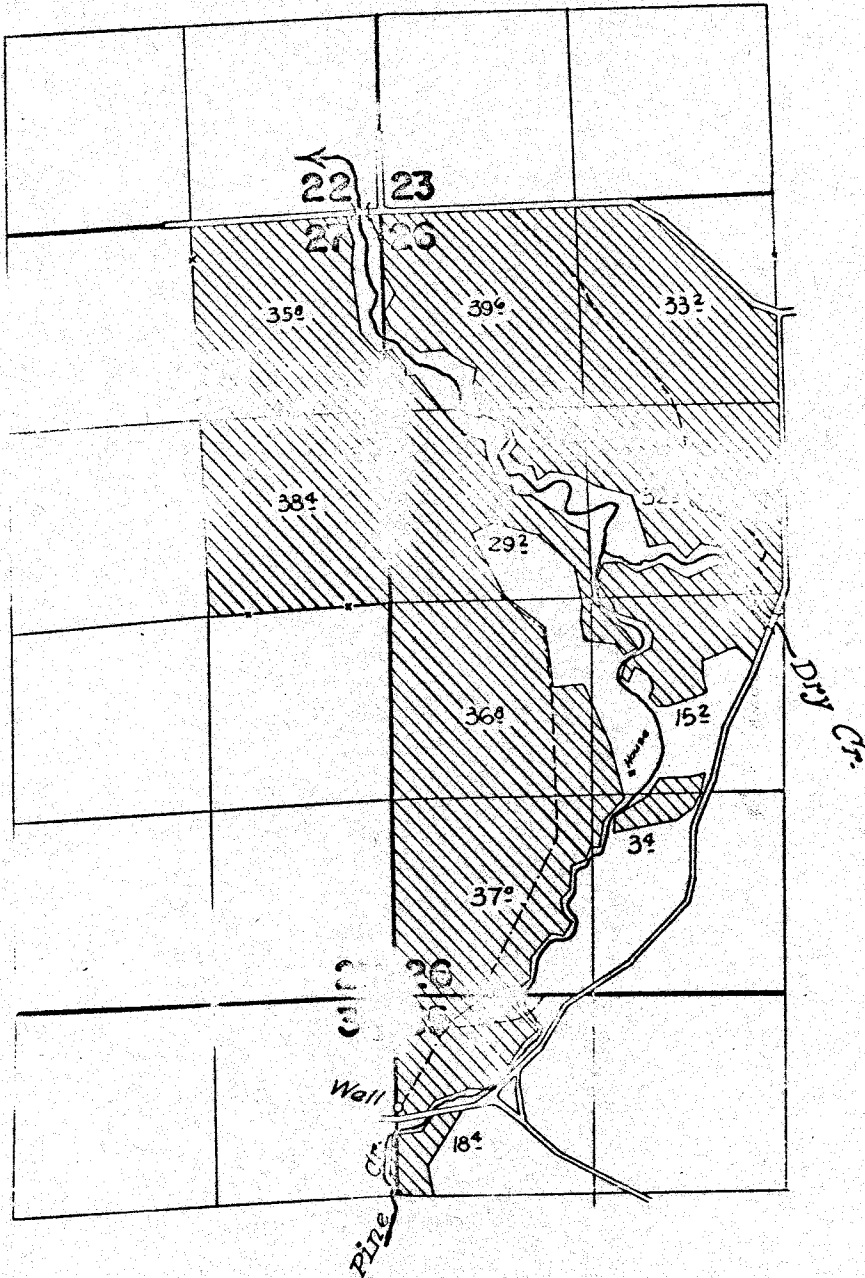

FINAL PROOF SURVEY UNDER

Application No. U-294 Permit No. U-269...
IN NAME OF

DOROTHY KELLY COCKBURN

Surveyed Sept. 13-14 1962, by C. O. Bartela..