


T.6N.R.34E.W.M.

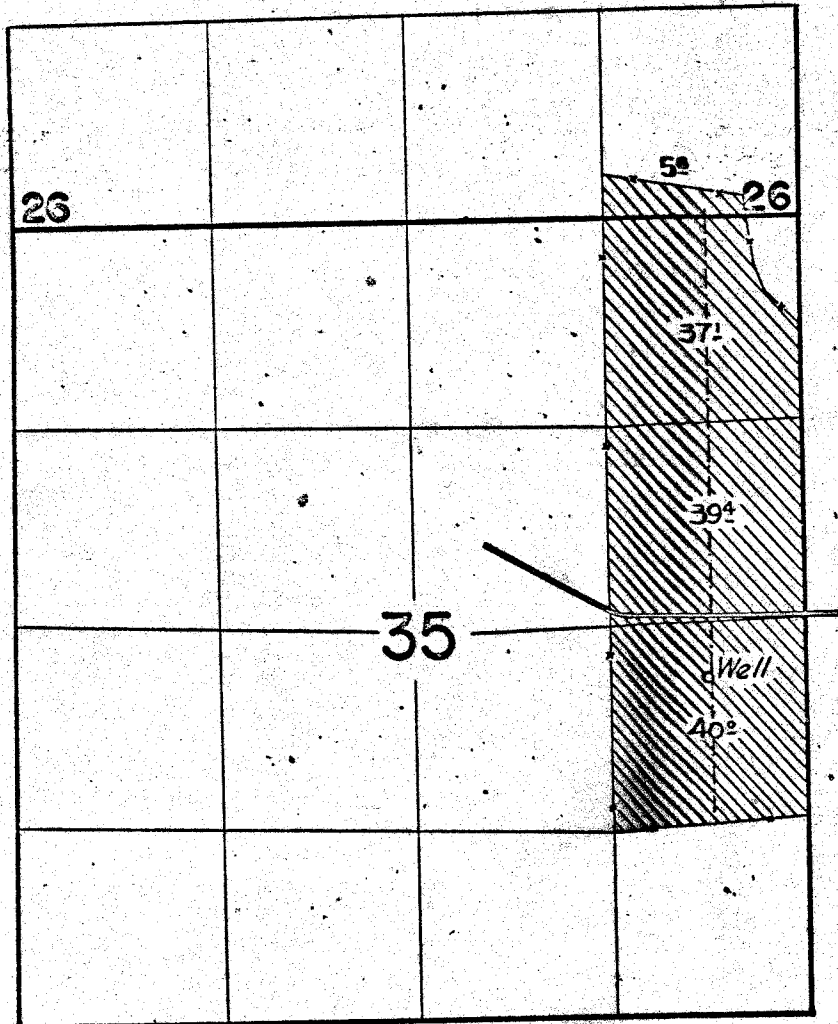

FINAL PROOF SURVEY UNDER

Application No. G-178..... Permit No. G-322
IN NAME OF

MERRILL A. BUROKER

July 18 1960, by M. Bish
Surveyed Sept. 12, 1961, by C.O. Bertels