


# T.6N.R.34E.W.M.

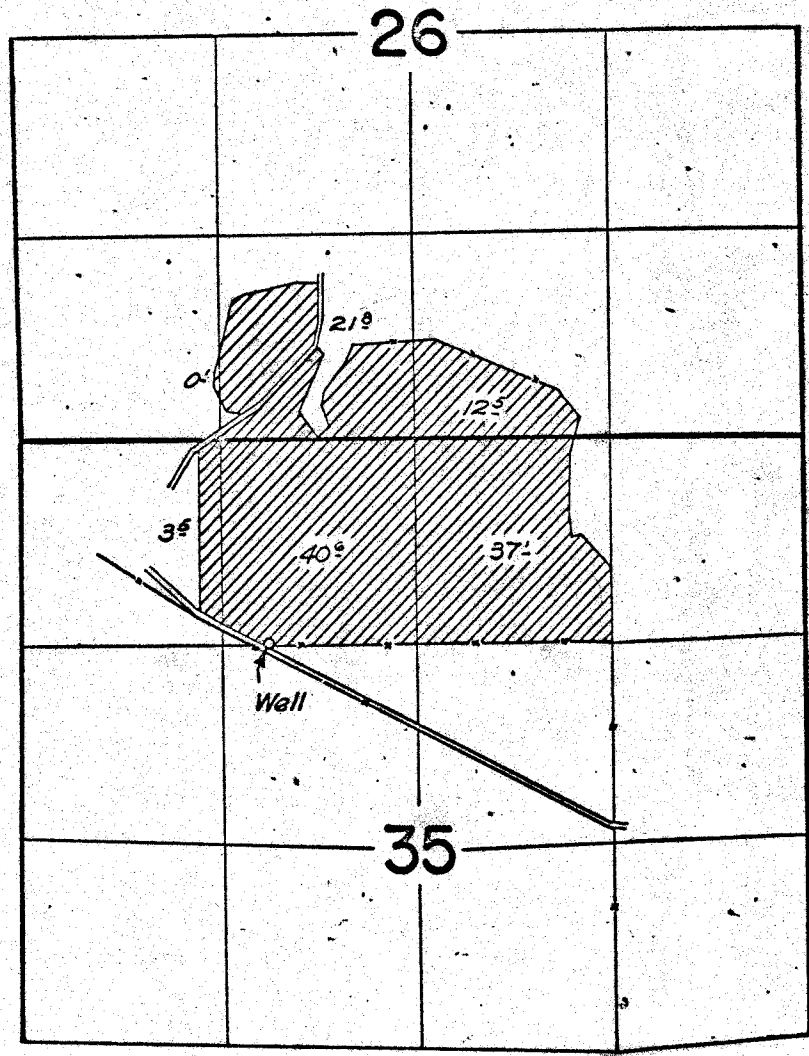

## FINAL PROOF SURVEY UNDER

Application No. G-520... Permit No. G-464...  
IN NAME OF

L. M. MARLATT

July 18 & 19 1960 by M. Bish  
Surveyed Sept. 13, 1961, by G. Q. Bartels.