


T. 1 N. R. 14 E. W.M.

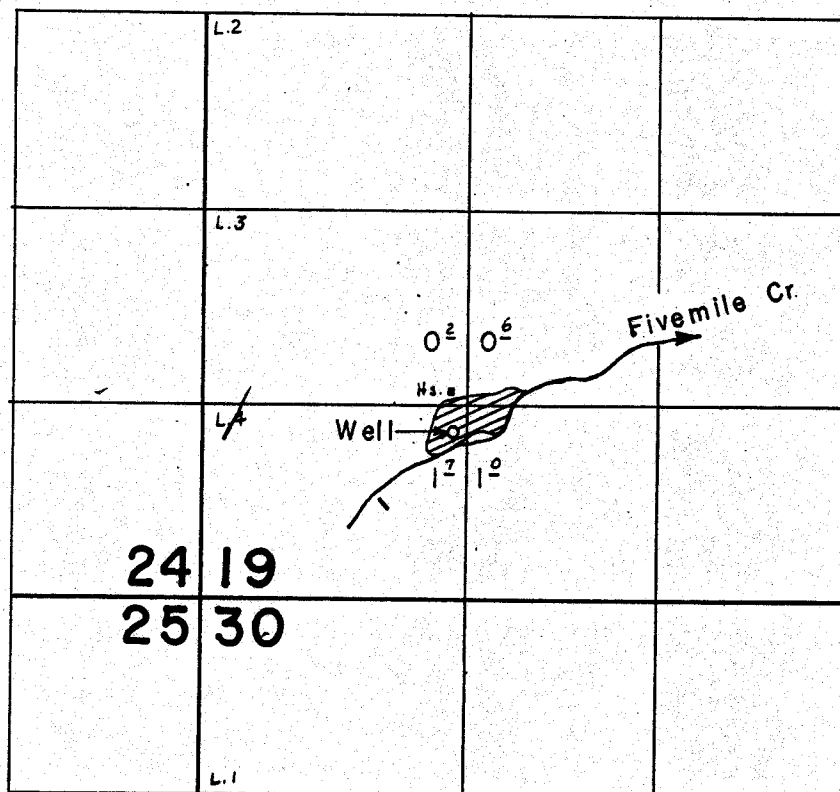

FINAL PROOF SURVEY UNDER

Application No. G-428 Permit No. G-306.
IN NAME OF

ELLA MAE ELLISON

Surveyed April 5 1962, by *L.W. Jelouach*