


T. 2 N. R. 12 E. W.M.

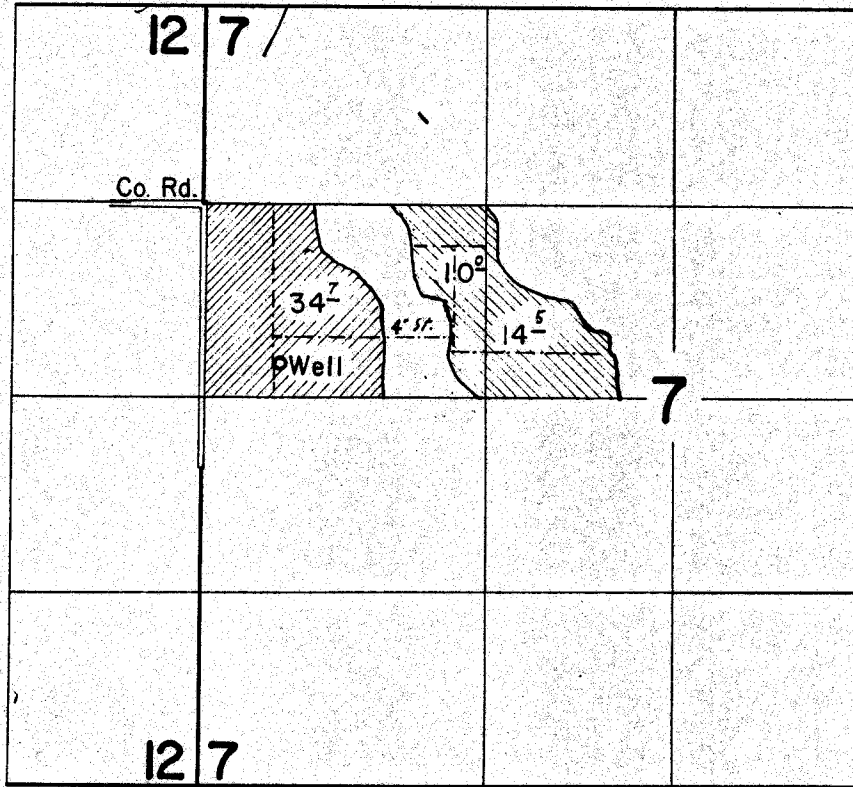

FINAL PROOF SURVEY UNDER

Application No. G-1859 Permit No. G-1701
IN NAME OF

DARRELL EVANS

Surveyed June 8 1962. by *L. W. Jelousek*