


G-1505

# T.1N.R.13E.W.M.

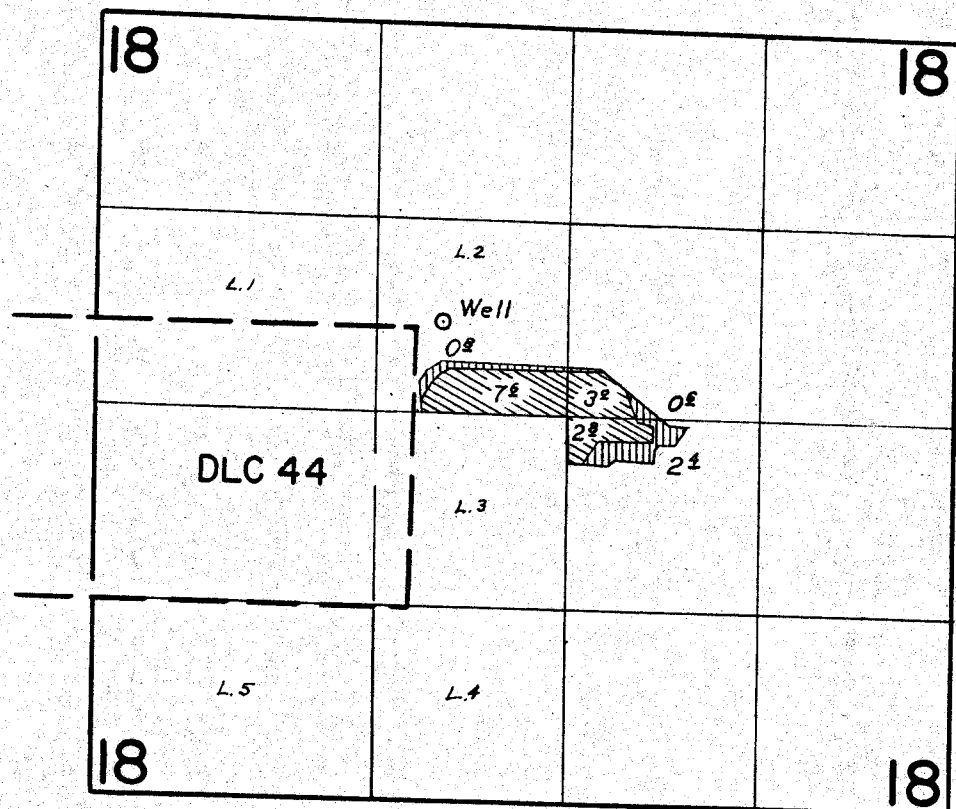

  
 Primary

  
 Supplemental

## FINAL PROOF SURVEY UNDER

Application No. G-22 Permit No. G-1505  
 IN NAME OF

*Bruce H. Hull*

Surveyed April 13 1962, by Thomas B. Laur...