


Surveyed April 12 1962, by *A. W. Gissel*

ALVEN J. GISSEL

Application No. 24887 Permit No. 21654  
IN NAME OF

FINAL PROOF SURVEY  
UNDER

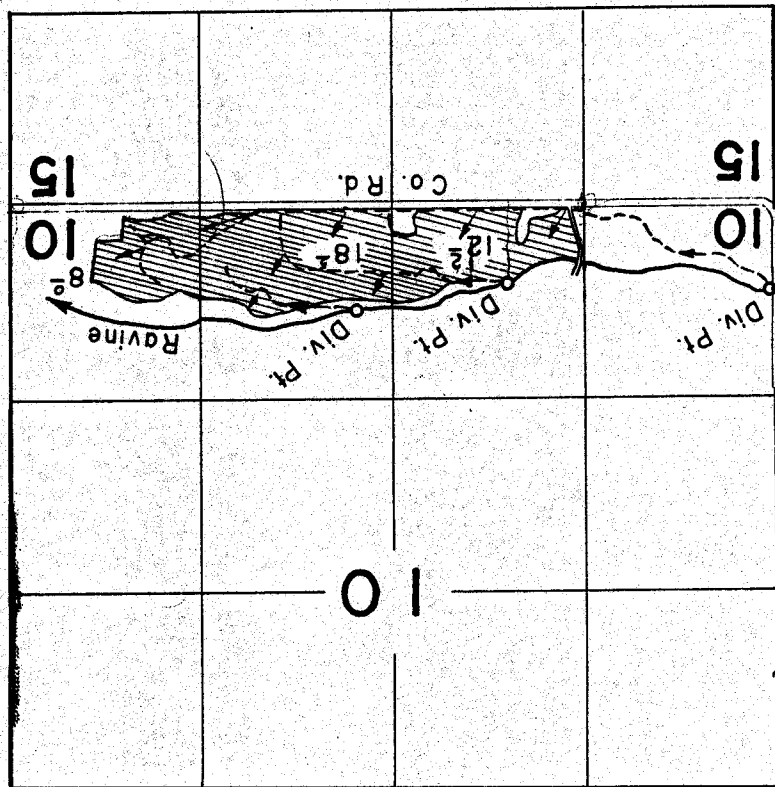

T. 4 S. R. 12 E. W. M.

21654