


26539

# T. 4 S. R. 11 E. W.M.

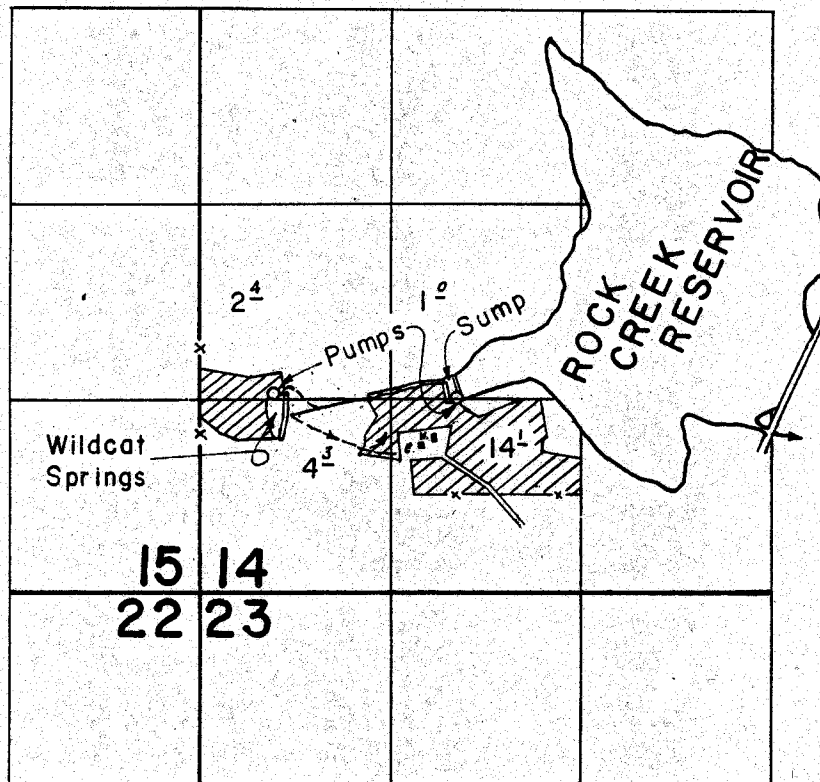

## FINAL PROOF SURVEY UNDER

Application No. 32589 Permit No. 26539  
IN NAME OF

**E. R. SMART**

Surveyed May 23 1962, by *L. W. Johnson*