


T. 2S. R. 3 W. W. M.

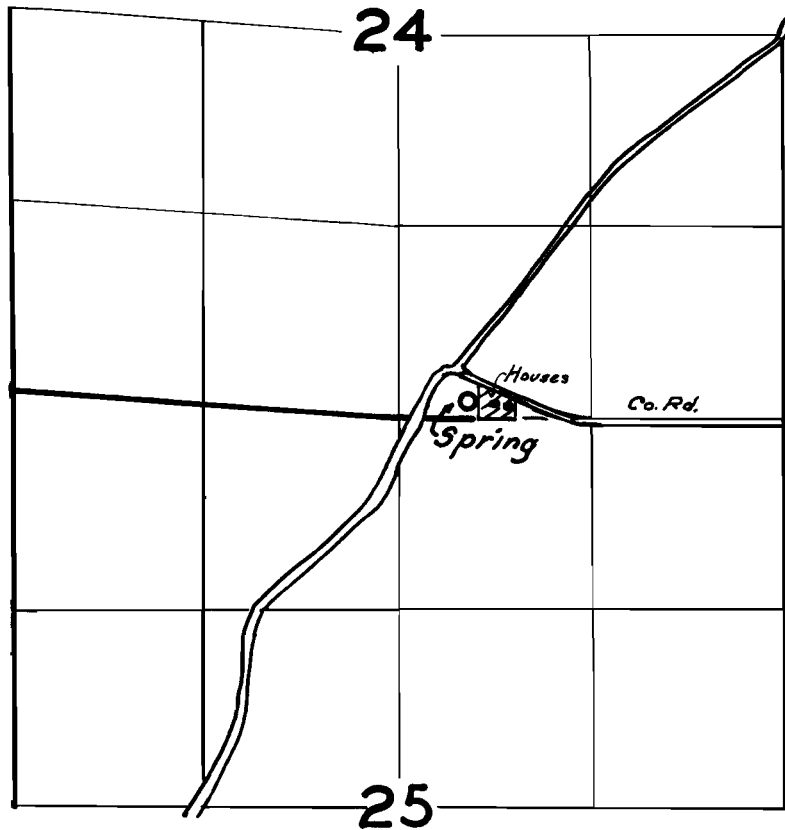

FINAL PROOF SURVEY
UNDER

Application No. 35655 Permit No. 27592
IN NAME OF

Frank and Irene H. Shine

Surveyed *1 May* 1962, by *Carl R. Baker*