


T. 10 S. R. 5 W. W. M

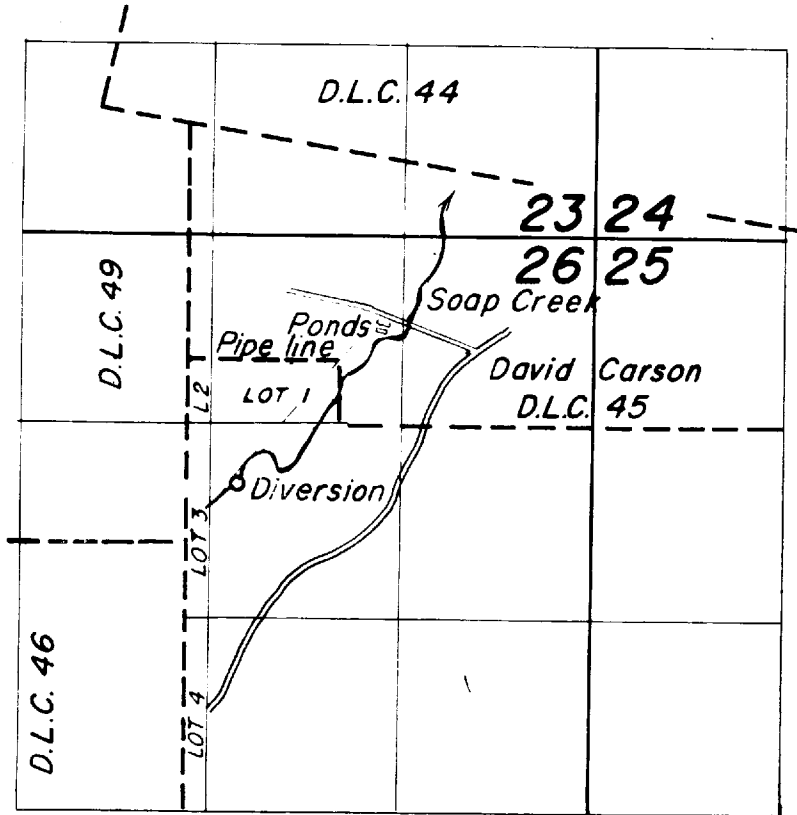

FINAL PROOF SURVEY
UNDER

35872 27582
Application No. R-35871 Perm't No. R-2664
IN NAME OF

U.S. Department of Agriculture

Surveyed Nov. 14 1962 by *Boyd L. Siegmund*