


T. 10 S. R. 5 W. W. M

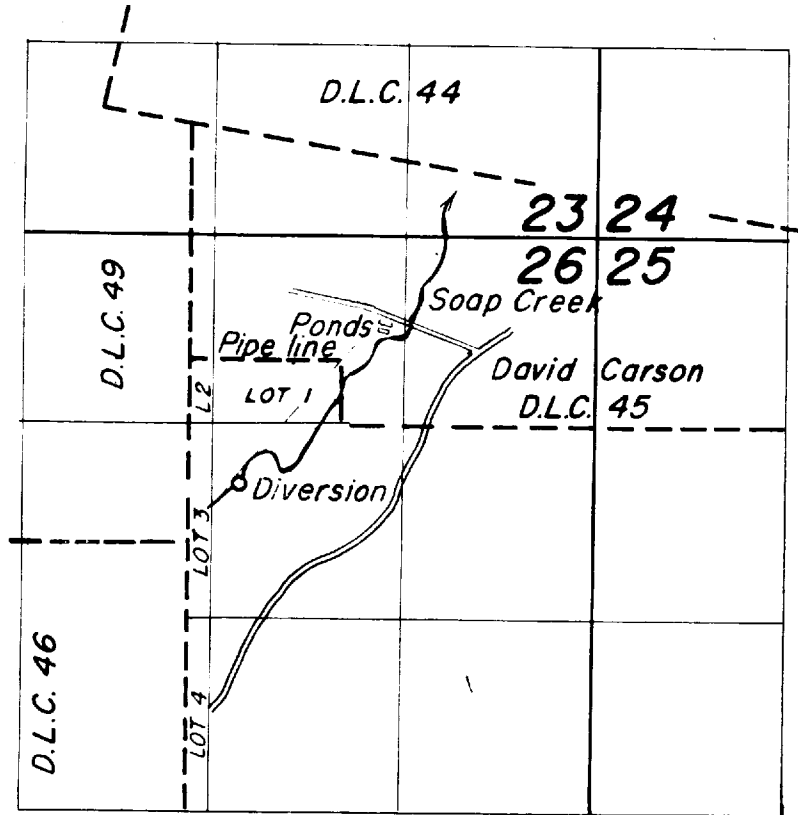

FINAL PROOF SURVEY  
UNDER

35872                      27582  
Application No. R-35871    Permit No. R-2664  
IN NAME OF

**U.S. Department of Agriculture**

Surveyed Nov. 14 1962 by *Roy L. Siegmund*