


T.3S.R.1E.W.M.

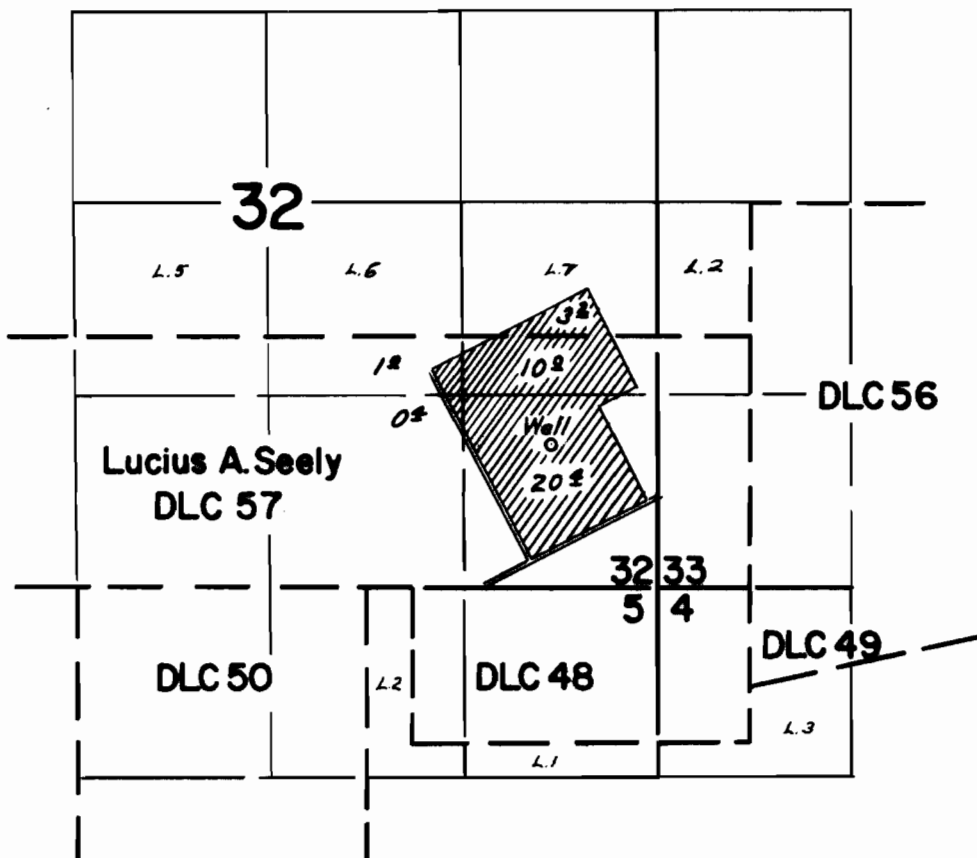

FINAL PROOF SURVEY UNDER

Application No. *G-1372*... Permit No. *G-1246*...
IN NAME OF

Vitandra Ditemmase & Christ T. Schlunegger

Surveyed *April 23, 1962*, by *Thomas B. Lauer*