


T.2S.R.3E.W.M.

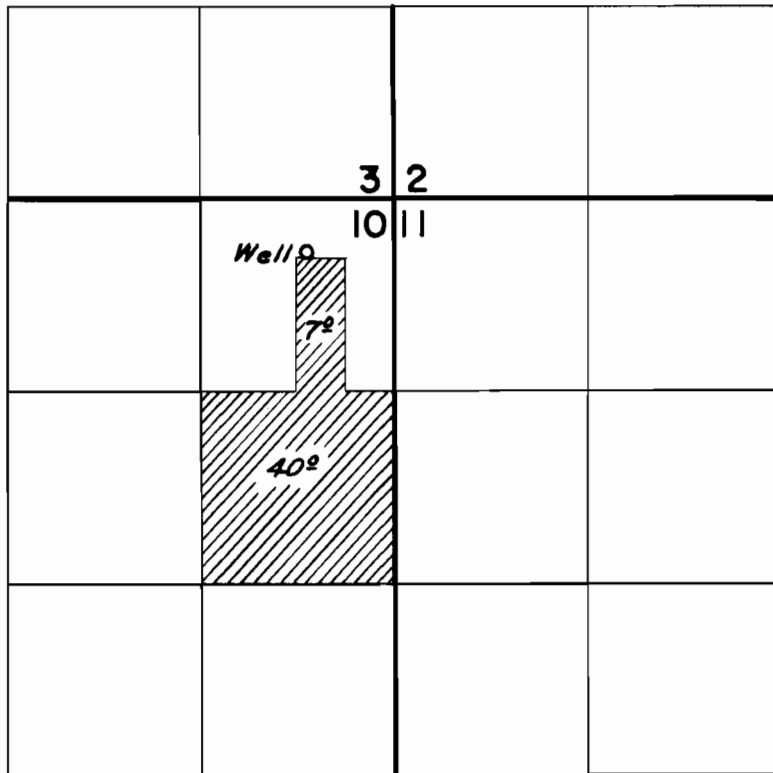

FINAL PROOF SURVEY
UNDER

Application No. *G-1799* Permit No. *G-1645*
IN NAME OF

Katsumi Sunamoto

Surveyed *April 25 1962*, by *Thomas R. Lauer*