


T.5S.R.2E.W.M.

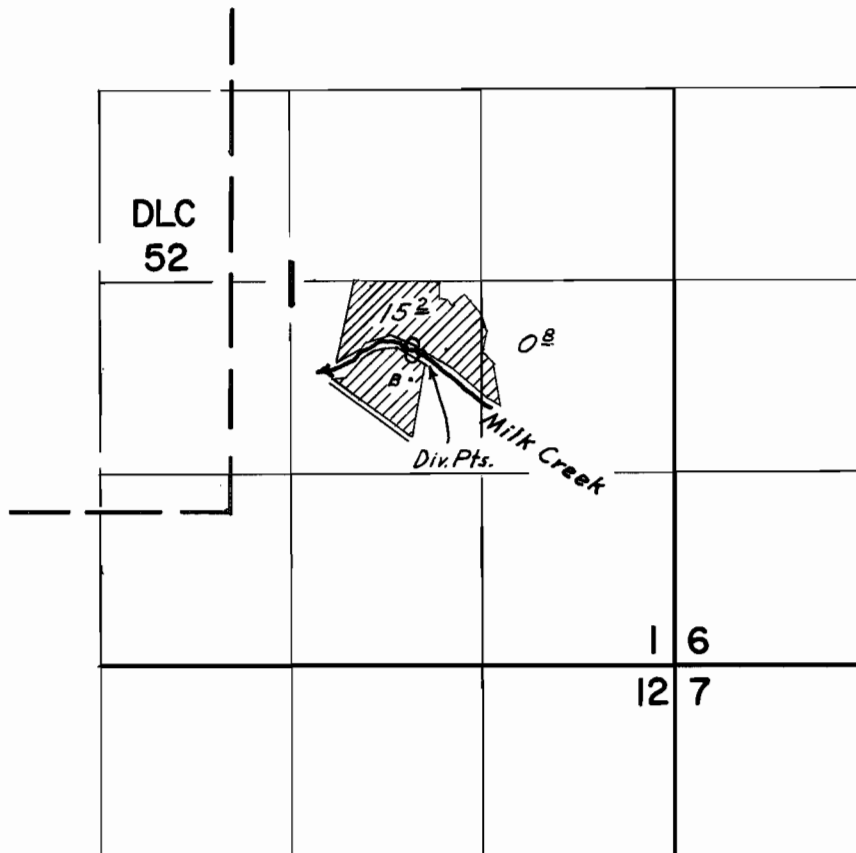

FINAL PROOF SURVEY UNDER

Application No. 33767... Permit No. 26660..
IN NAME OF

Otis O. Hunt

Surveyed April 26... 1962., by Thomas R. Lauer