


Per 26501
30662

T.10S. R.32E.W.M.

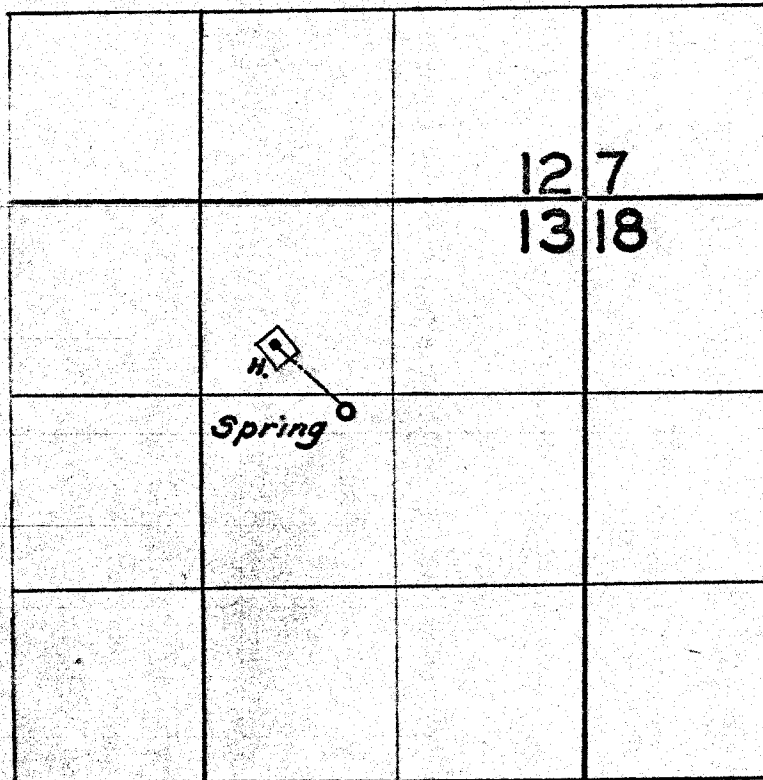

FINAL PROOF SURVEY
UNDER

Application No. 33504 Permit No. 26501
IN NAME OF

Eva Shields

Surveyed 13 Nov. 1962, by Carl R. Baker

1962-X