


collecting tile 30'
Spring. Elev. 4327.

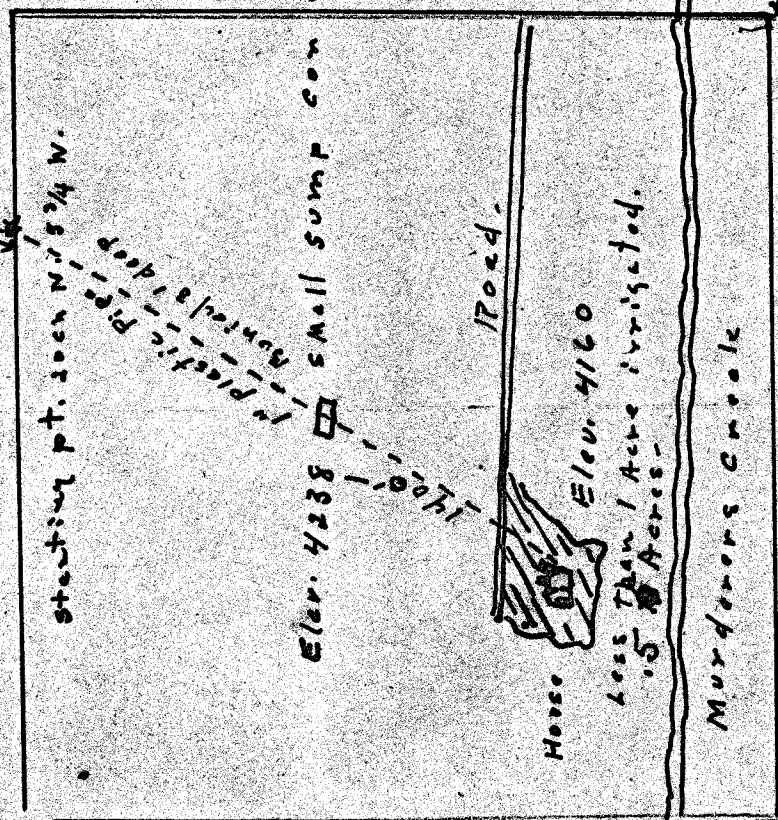

RECEIVED
JAN 28 1960
STATE ENGINEER
RECEIVED
AUG 21 1959
STATE ENGINEER
SALEM, OREGON

Sec. Cor. Comm'n To
Sec 10, 11, 14 & 15
Tp 15s. R. 28 E.W.M.

SE 1/4 of SE 1/4 - Sec 10 - 15 - 28

Application No. 33287

Permit No. 26727