


Div Pt. LOCATED  
IN LOT 4, ASST LOT 5  
(SHINE 40)

# T.36S. R.3 W.W.M.

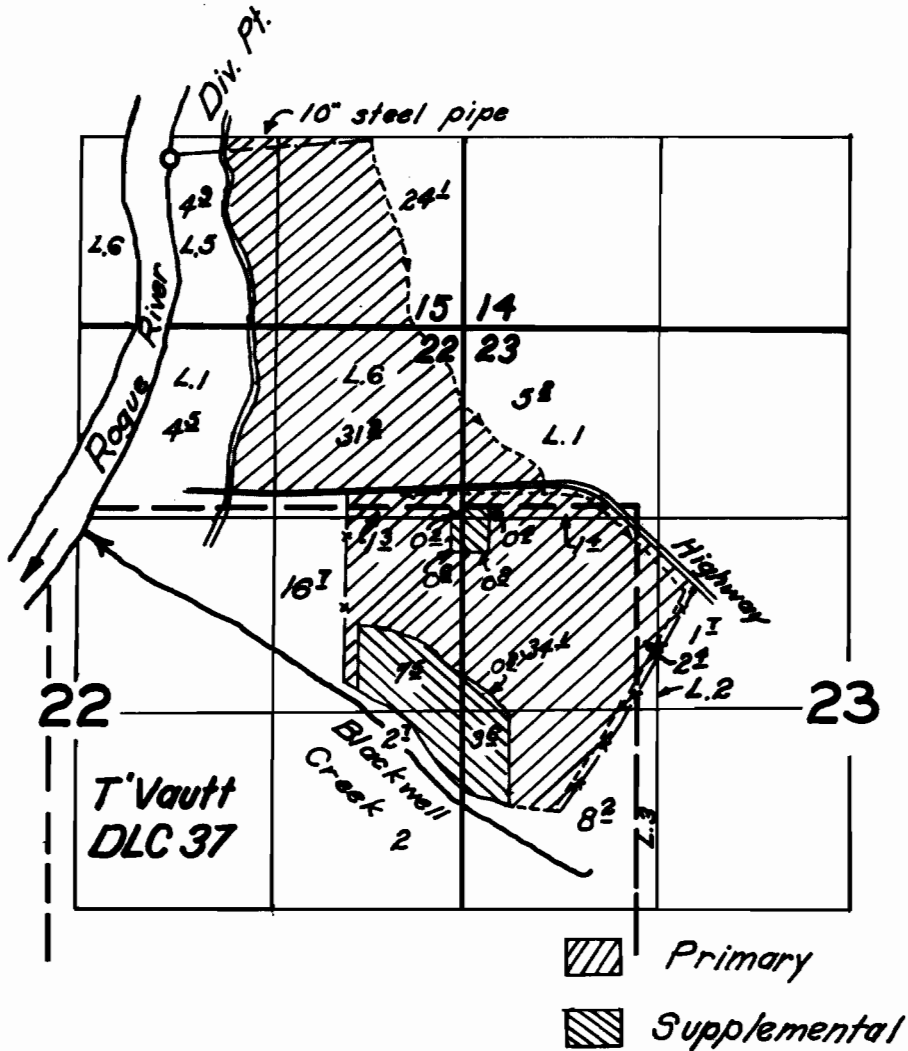

## FINAL PROOF SURVEY UNDER

Application No. 31122 Permit No. 24546  
IN NAME OF

Chayner Thompson

Surveyed 14 April 1962., by Carl R. Baker