


T.16S.R.4W.W.M.

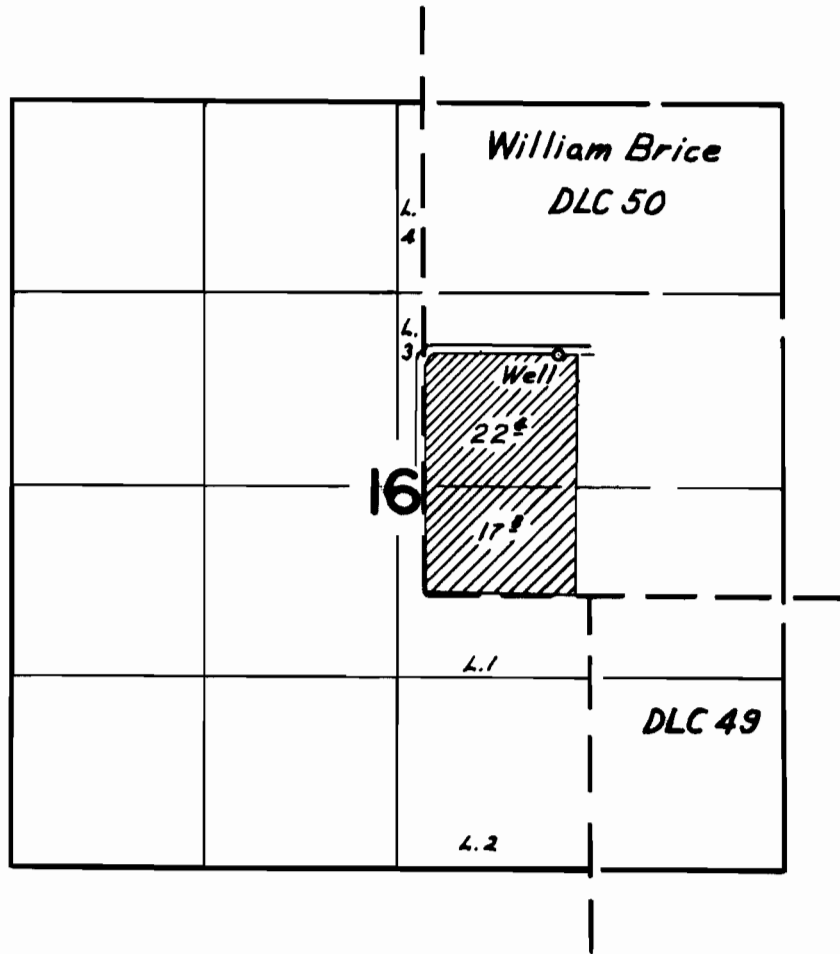

**FINAL PROOF SURVEY**  
UNDER

Application No. *G-1716* Permit No. *G-1574*  
IN NAME OF

*Thomas J. Harper*

Surveyed *May 2* 19*62*, by *Thomas R. Lauer*