


T.17S.R.IW.W.M.

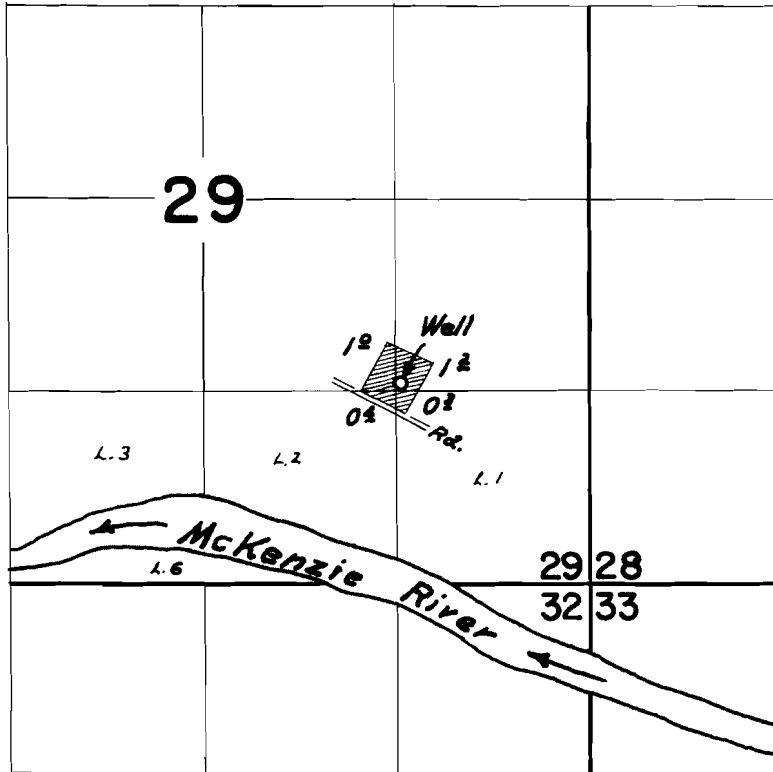

**FINAL PROOF SURVEY**  
UNDER

Application No. G-1991 Permit No. G-1892  
IN NAME OF

Percy L. + Edna S. DeBell

Surveyed May 11, 1962, by Thomas R. Lauer