


T.16S.R.4W.W.M.

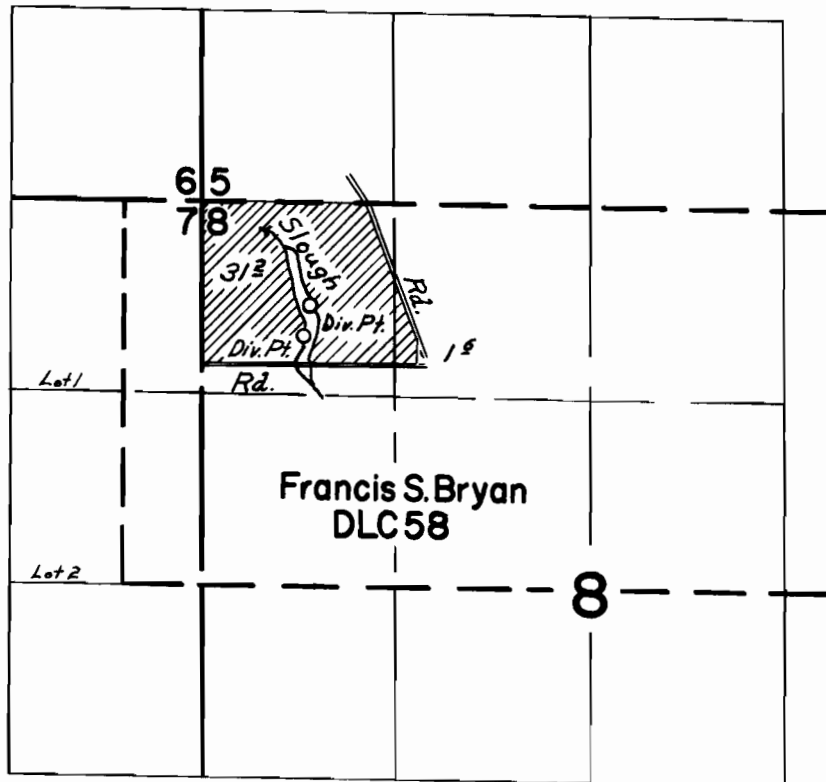

FINAL PROOF SURVEY UNDER

Application No. 32566 Permit No. 25709
IN NAME OF

George Nielsen

Surveyed May 1, 1962, by Thomas R. Lauer