


T.16S.R.7W.W.M.

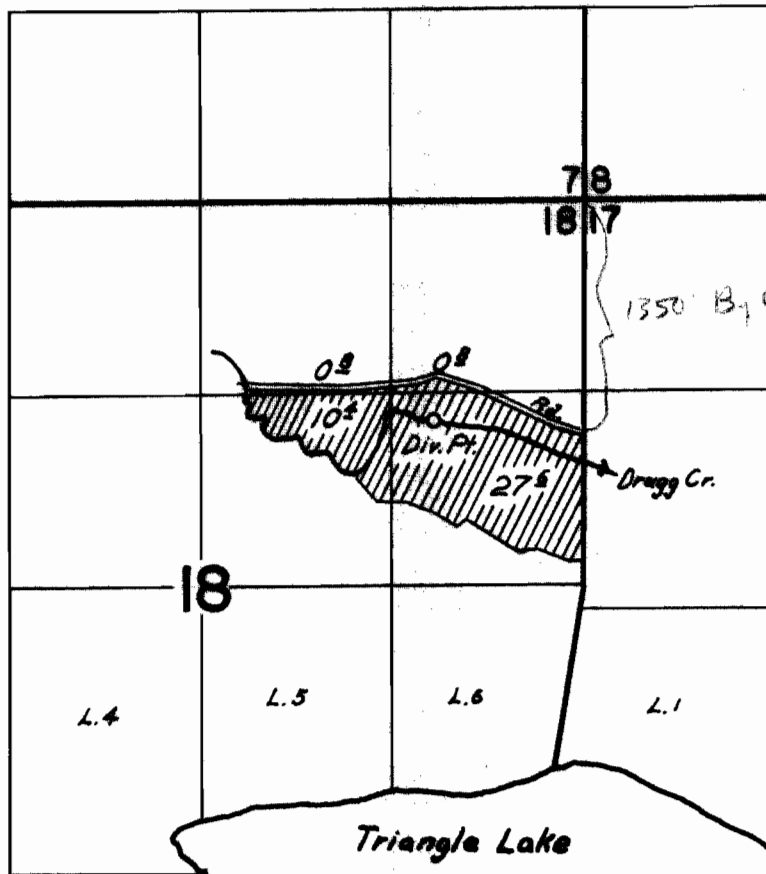

DRAFTED
WRONG

FINAL PROOF SURVEY
UNDER

Application No. 33024..... Permit No. 26126.....
IN NAME OF

.....*Charles R. Tipton*.....

Surveyed *May 2*..... 1962., by *Thomas R. Lauer*.