


T.16S.R.7W.W.M.

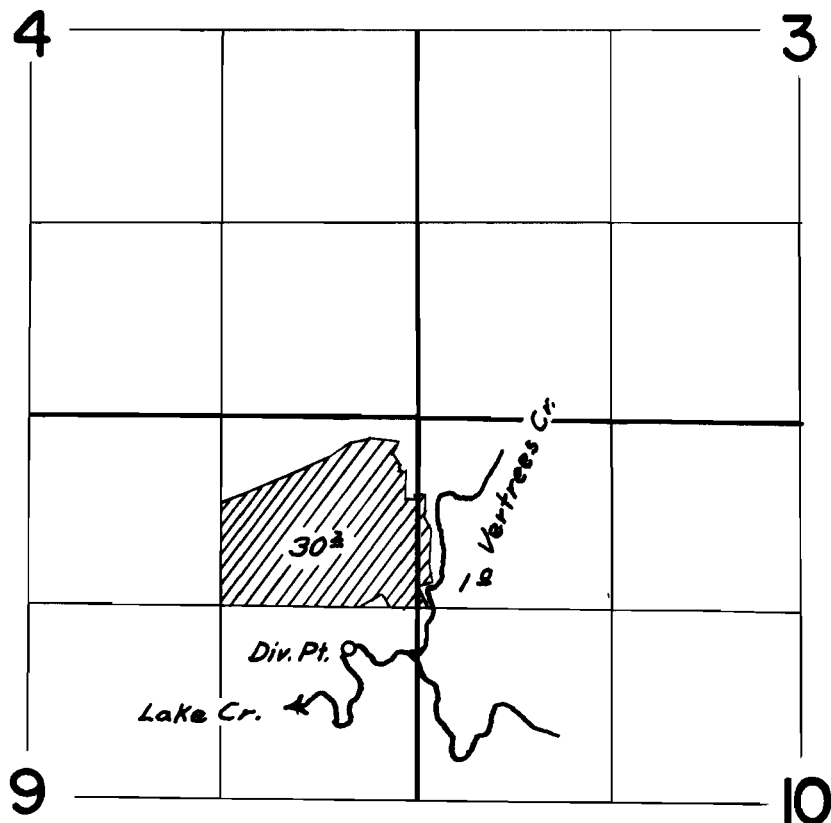

FINAL PROOF SURVEY
UNDER

Application No. 34077 Permit No. 26790
IN NAME OF

Robert M. Shrode

Surveyed May 2 1962, by Thomas R. Lauer