


T. 22S. R.3W.W.M.

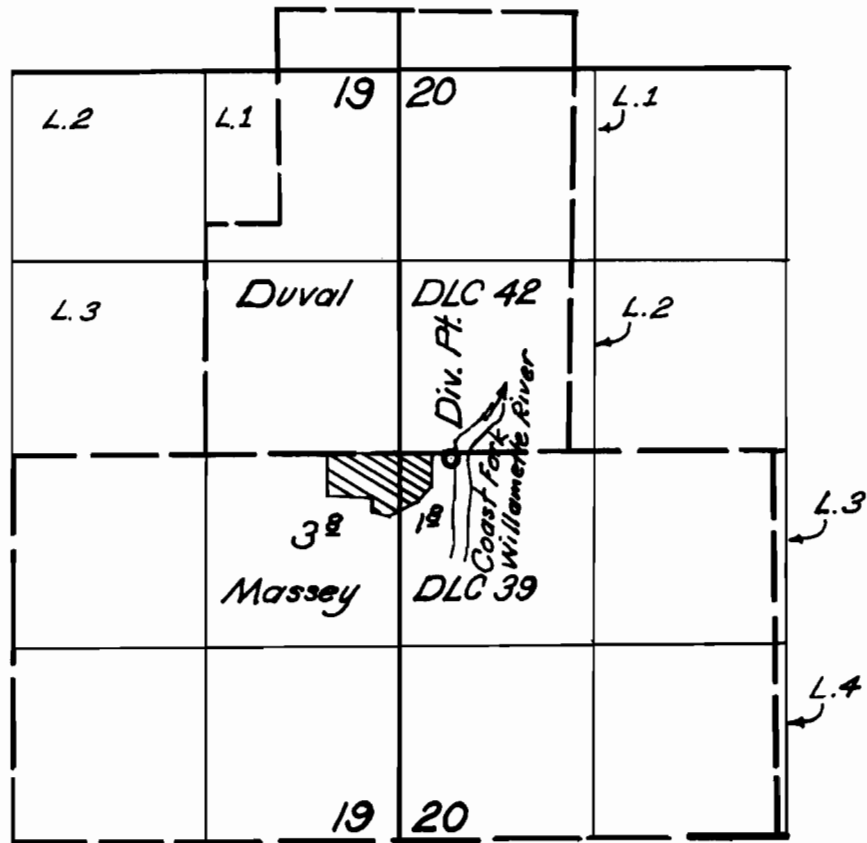

FINAL PROOF SURVEY
UNDER

Application No. 34023. Permit No. 26833.
IN NAME OF

Raymond Sloan

Surveyed 23 April 1962., by Carl R. Baker