


T.17S.R.IW.W.M.

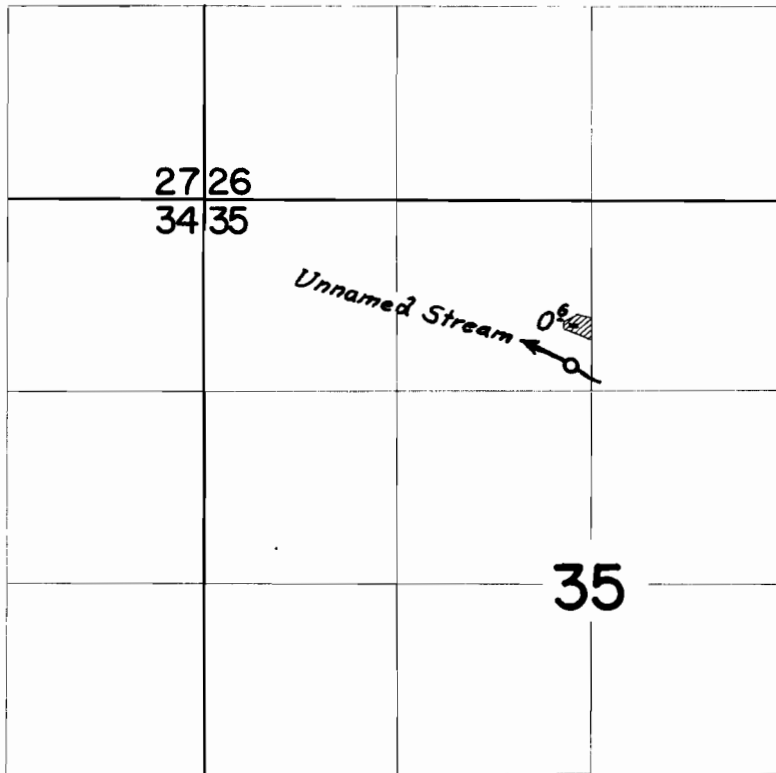

FINAL PROOF SURVEY
UNDER

Application No. *34264* Permit No. *26964*
IN NAME OF

Arthur F. Brinkman

Surveyed *May 11, 1962*, by *Thomas A. Lauer*