


T.16S.R.1W.W.M.

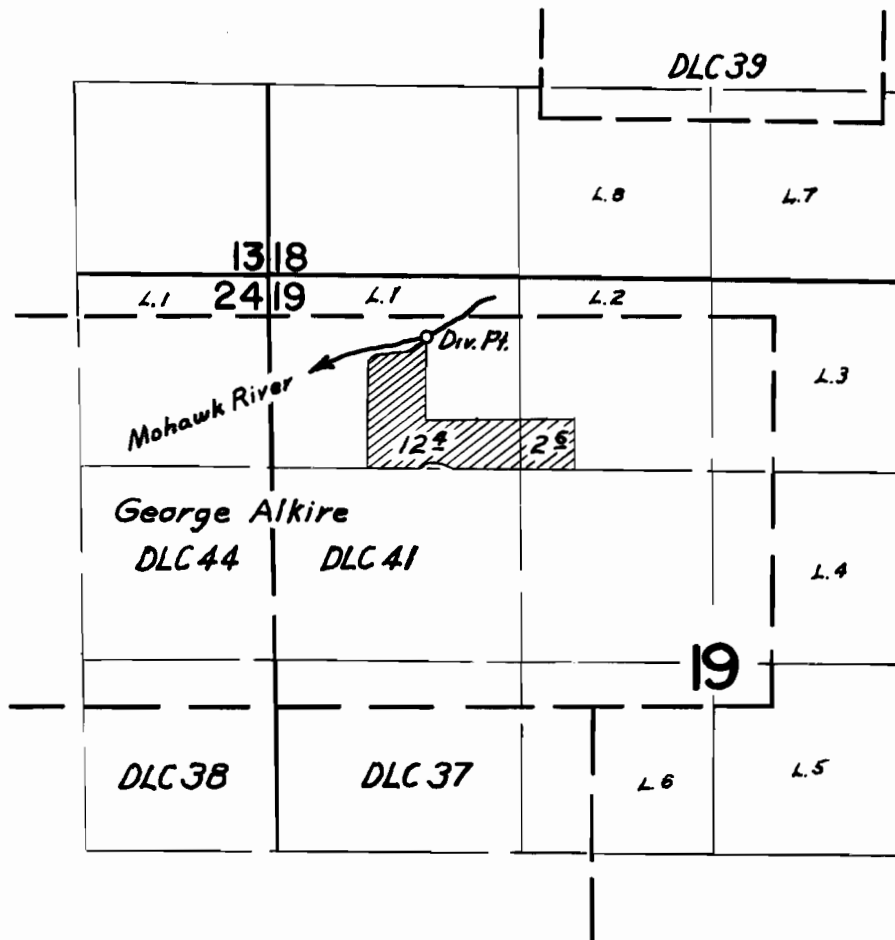

FINAL PROOF SURVEY UNDER

Application No. 34576 Permit No. 27154
IN NAME OF

Glenn K. Stevens

Surveyed May 3 1962, by Thomas R. Lauer