


T.10S. R.3 W.W.M.

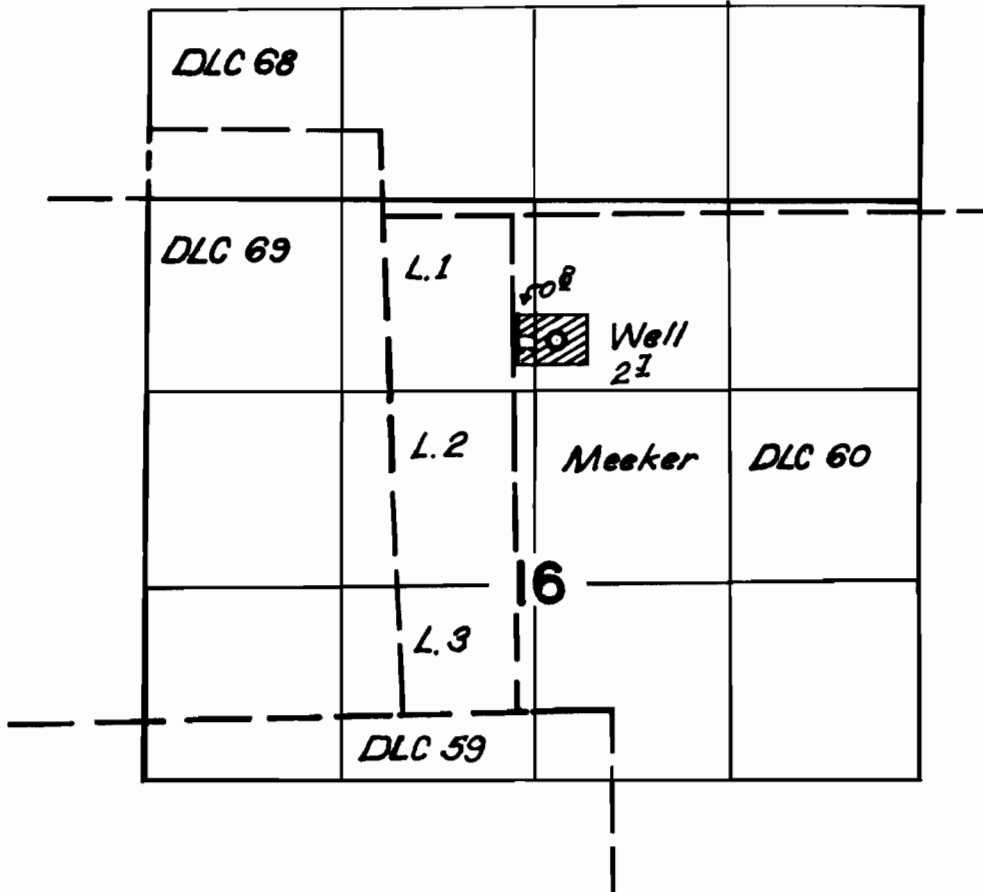

**FINAL PROOF SURVEY**  
UNDER

Application No. *G-1049* Permit No. *G-930*  
IN NAME OF

*Lucy Jellison*

Surveyed *5 April* 19*62*, by *Carl R. Baker*