


T.9S.R.3E.W.M.

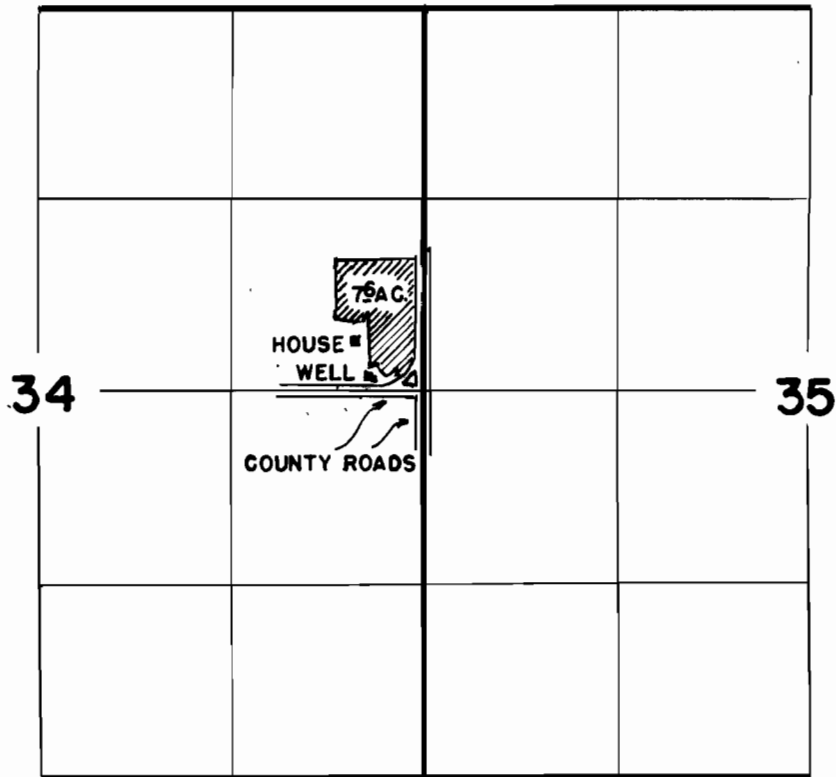

FINAL PROOF SURVEY
UNDER

Application No. G-1343 Permit No. G-1211
IN NAME OF

Byron F. Davis

Surveyed Nov. 19 1962, by Floyd L. Siegmund