
T.10S. R.3 W.W. M.

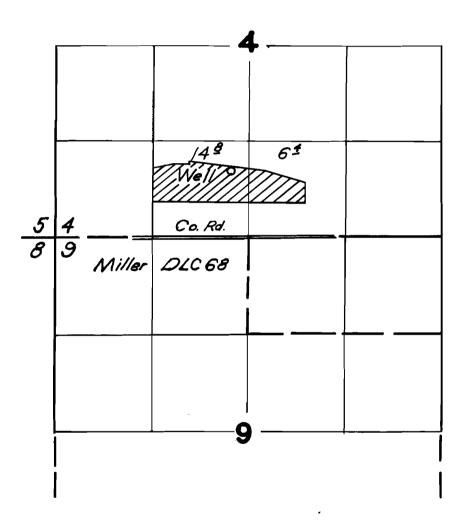

FINAL PROOF SURVEY

Application No. <i>G-2029</i> Permit No. <i>G-1866</i> IN NAME OF
Francis L. Holt
Surveyed 30 Mar. 1962, by Carl R. Baker.