


T. 10 S. R. 1 E. W. M.

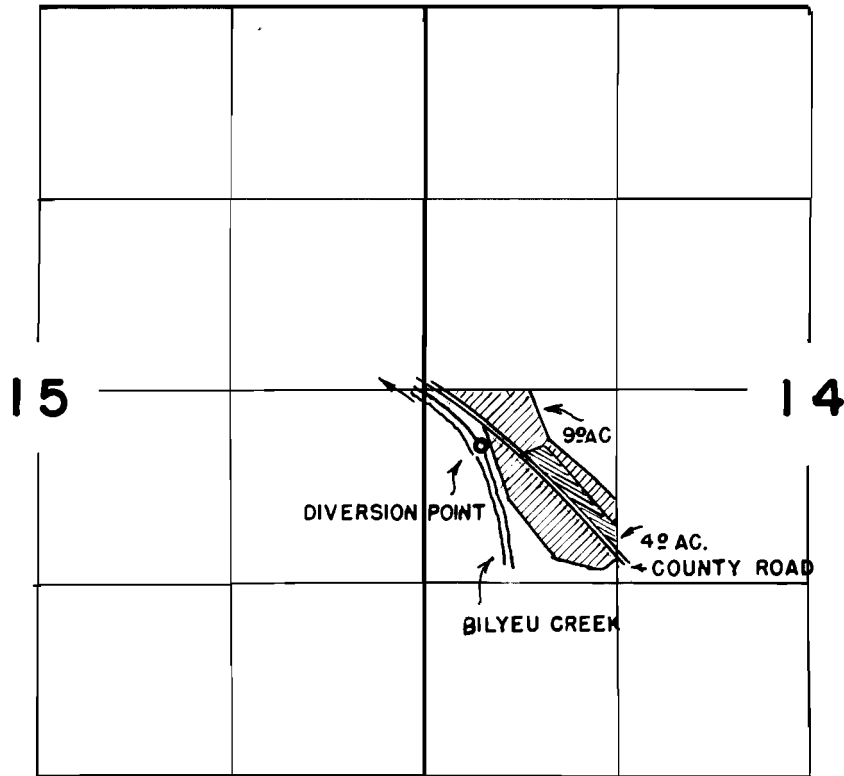

**FINAL PROOF SURVEY**  
UNDER

28126                      22139  
Application No. 31440    Permit No. 24797  
IN NAME OF

**Henry & Frances Riester**

Surveyed Nov. 19... 1962, by *Floyd L. Sigmund*