


T. 10 S. R. 1 E. W. M.

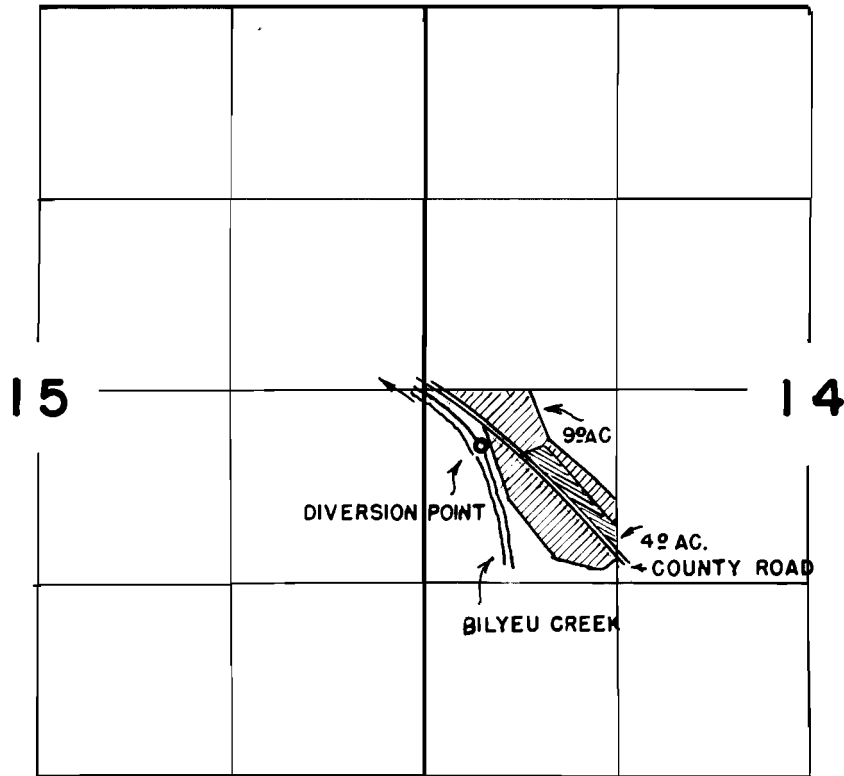

FINAL PROOF SURVEY
UNDER

28126 22139
Application No. 31440 Permit No. 24797
IN NAME OF

Henry & Frances Riester

Surveyed Nov. 19... 1962, by *Floyd L. Sigmund*