


T. 9 S. R. 3 E. W. M.

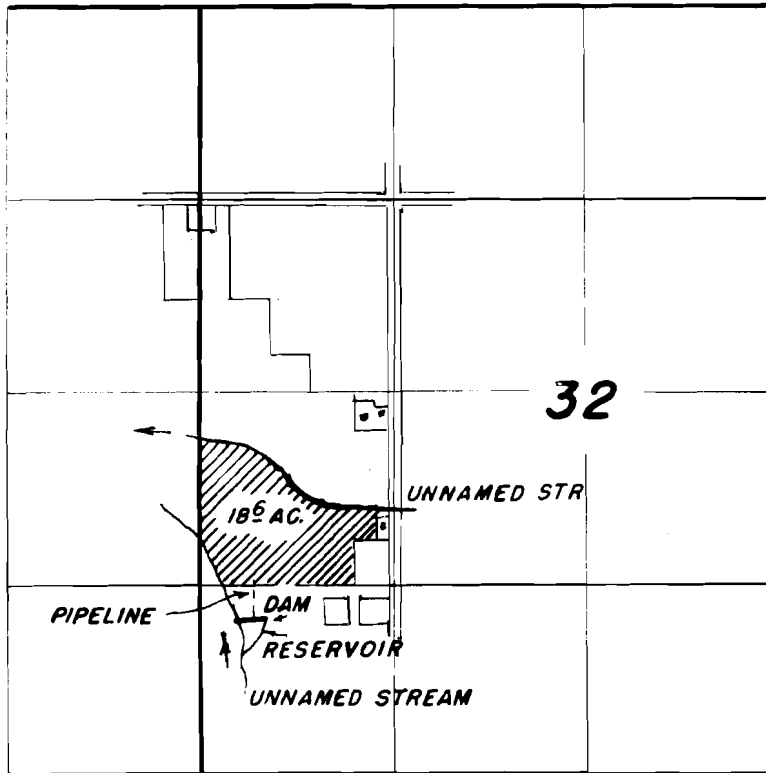

FINAL PROOF SURVEY
UNDER

Application No. ³¹⁷⁵⁷ R-31756 Permit No. ²⁵⁰⁸⁵ R-2065
IN NAME OF

Donald Marshall

Surveyed Dec. 5 1962, by *Floyd L. Siegmund*.