


T. 9 S. R. 3 E. W. M.

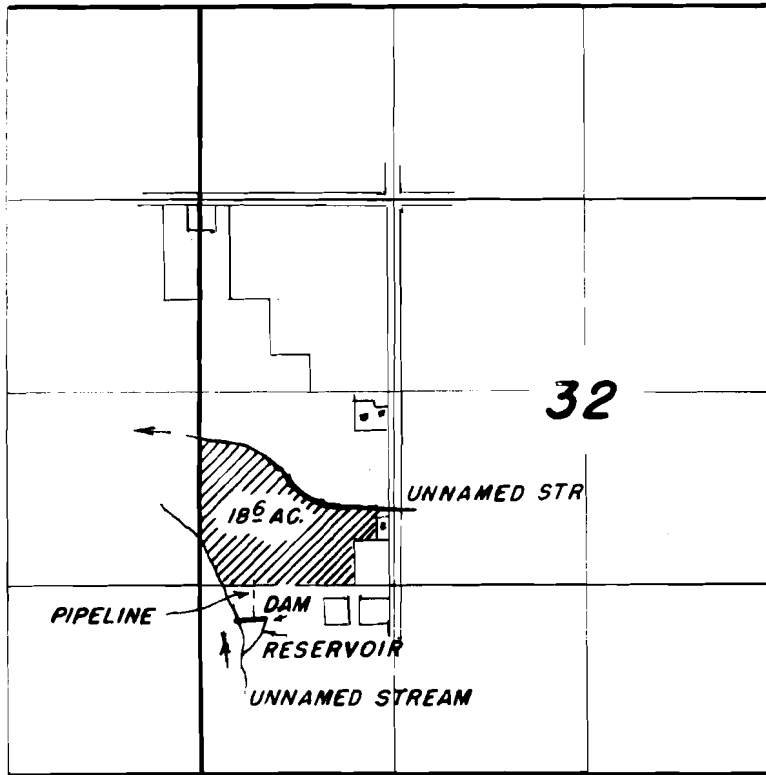

FINAL PROOF SURVEY  
UNDER

Application No. <sup>31757</sup> R-31756 Permit No. <sup>25085</sup> R-2065  
IN NAME OF

**Donald Marshall**

Surveyed Dec. 5 1962, by *Floyd L. Siegmund*.