


# T.9S.R.IW.W.M.

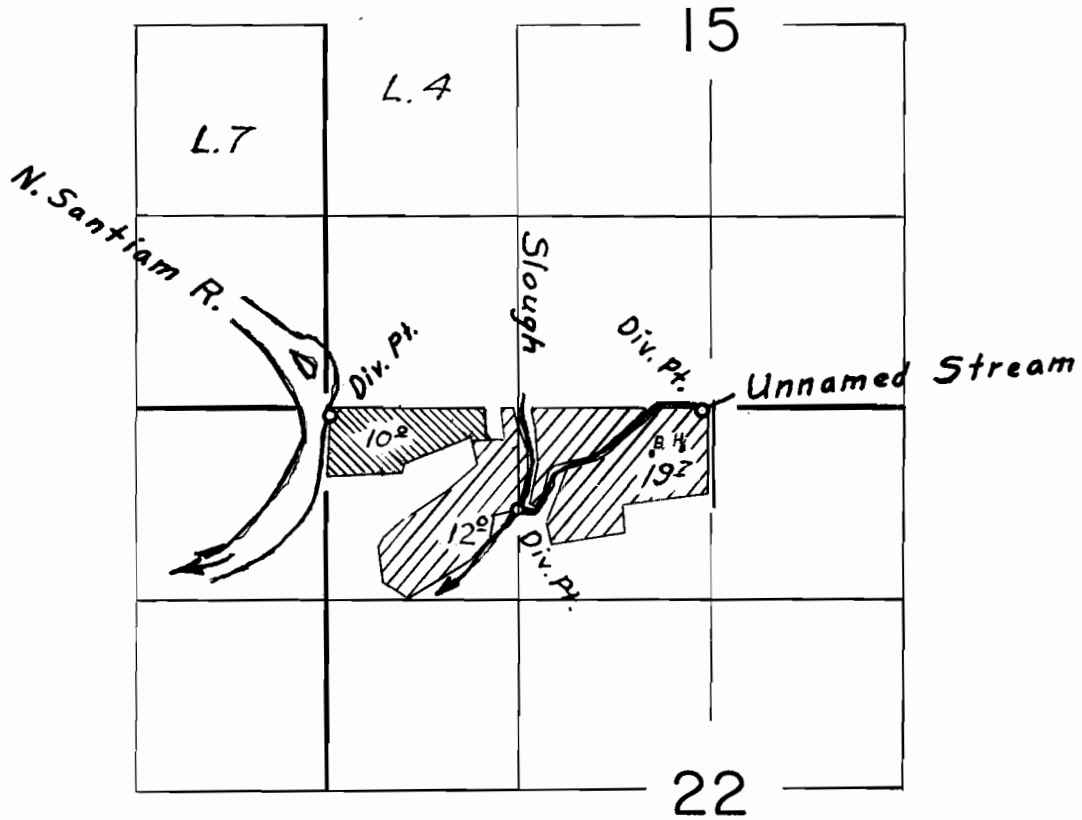

From River

From Creek

## FINAL PROOF SURVEY UNDER

Application No. 32171 Permit No. 25410  
IN NAME OF

Maurice S. Fery

Surveyed March 28 1962, by Thomas R. Lauer