


T.12S. R.1E. W.M.

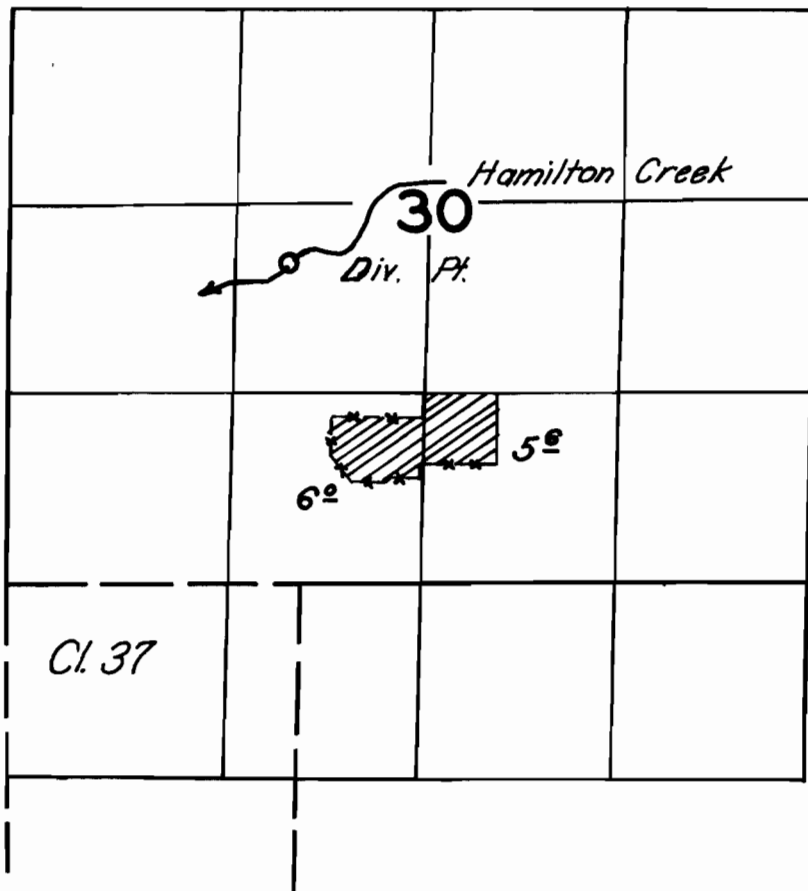

FINAL PROOF SURVEY
UNDER

Application No. J2904 Permit No. 25978
IN NAME OF

Gloyd Adams

Surveyed 3 April 1962, by Carl R. Baker