


T.10S.R.2W.W.M.

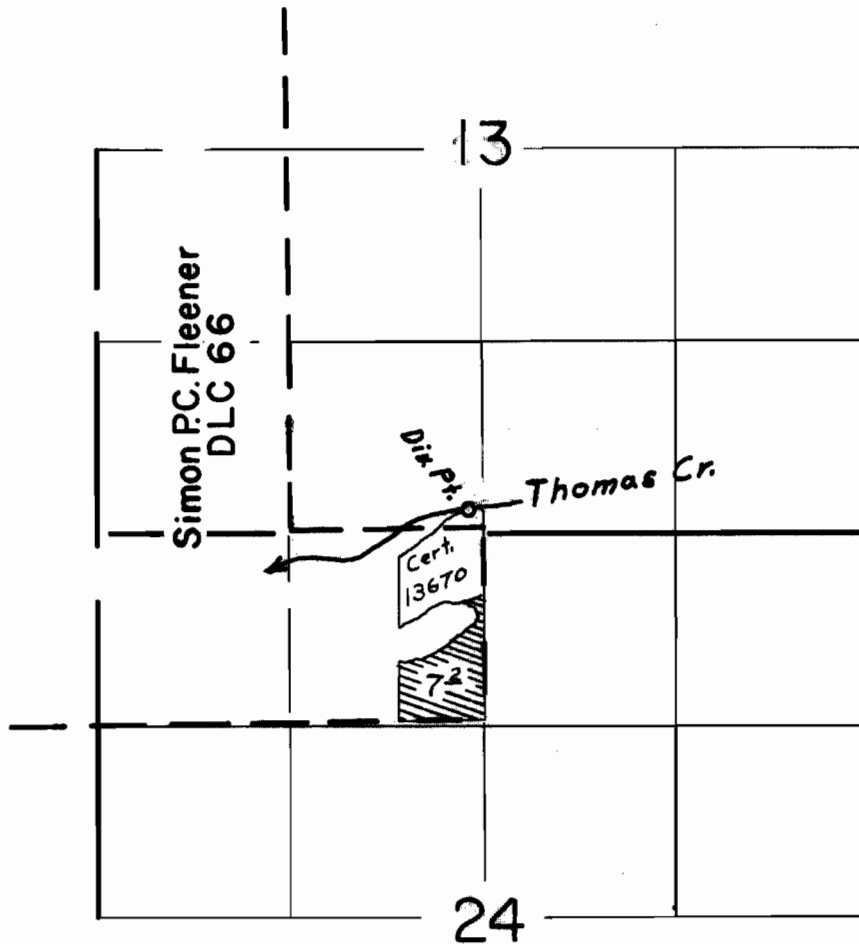

FINAL PROOF SURVEY
UNDER

Application No. 32995 Permit No. 26092
IN NAME OF

Leland W. & Margaret Moore

Surveyed March 26 1962 by Thomas R. Layer