


T.10&11S.R.1W.W.M.

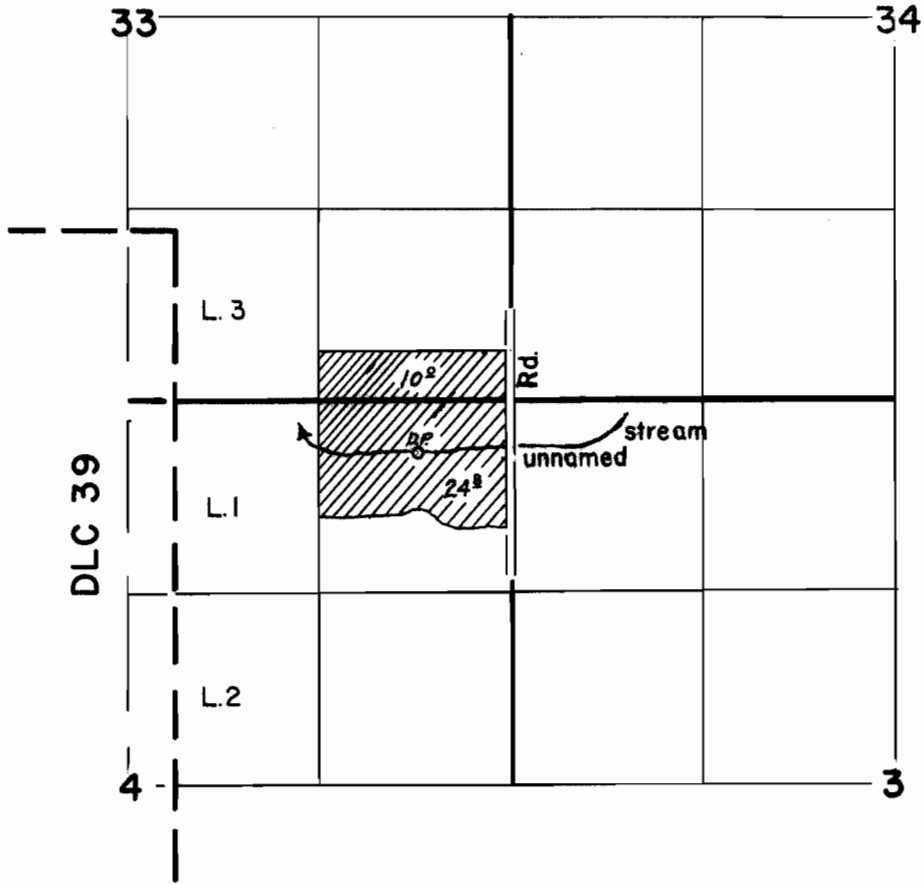

FINAL PROOF SURVEY UNDER

Application No. 33212 Permit No. 26258
IN NAME OF

Geno J. Luckini

Surveyed March 26 1962, by Thomas R. Layer
T.R. Layer